

CARD MUST BE TYPED

State of Kansas
NOTICE OF INTENTION TO DRILL
(see rules on reverse side)

CARD MUST BE SIGNED

Starting Date: 1 / 10 / 85
month / day / year

API Number 15- 163-22,592-0000

OPERATOR: License # 8925
Name Liberty Operations & Completions, Inc.

C.S/2 S/2 SW Sec 16. Twp 6.. S, Rge . 20. East West
(location)

Address 308 West Mill
City/State/Zip Plainville, KS 67663

330 Ft North from Southeast Corner of Section
3960 Ft West from Southeast Corner of Section

Contact Person David Comeau
Phone (913) 434-4686

(Note: Locate well on Section Plat on reverse side)

CONTRACTOR: License # 5665
Name Pioneer Drilling Company, Inc.
City/State Plainville, KS 67663

Nearest lease or unit boundary line 330 feet.
County Rooks
Lease Name Geyer Well# 1

Domestic well within 330 feet: yes no
Municipal well within one mile: yes no

Well Drilled For: Well Class: Type Equipment:
 Oil Swd Infield Mud Rotary
 Gas Inj Pool Ext. Air Rotary
 OWWO Expl Wildcat Cable

Depth to Bottom of fresh water 65 feet
Lowest usable water formation Dakota
Depth to Bottom of usable water ~~875~~ 1400 feet
Surface pipe by Alternate: 1 2
Surface pipe to be set 250 feet
Conductor pipe if any required N/A feet
Ground surface elevation feet MSL
This Authorization Expires 6-14-85
Approved By 12-14-84 *R*

If OWWO: old well info as follows:

Operator
Well Name
Comp Date Old Total Depth
Projected Total Depth 3720 feet
Projected Formation at TD Arbuckle
Expected Producing Formations Arbuckle


I certify that we will comply with K.S.A. 55-101, et seq., plus eventually plugging hole to K.C.C. specifications.

Date 12-11-84 Signature of Operator or Agent *D. Sheu* Title Vice President

Must be filed with the K.C.C. five (5) days prior to commencing well
 This card void if drilling not started within six (6) months of date received by K.C.C.

Important procedures to follow :

**A Regular Section of Land
 1 Mile = 5,280 Ft.**

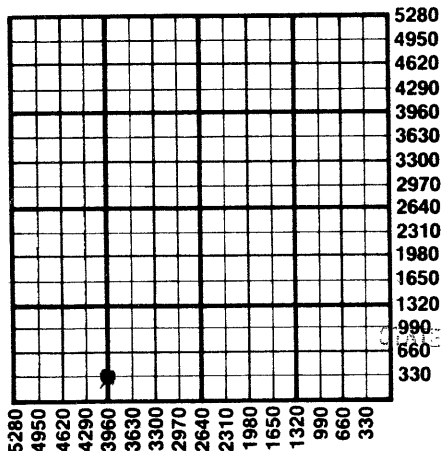

1. Notify District office before setting surface casing.
2. Set surface casing by circulating cement to the top.
3. File completion forms ACO-1 with K.C.C. within 90 days of well completion, following instructions on ACO-1, side 1, and including copies of wireline logs.
4. Notify District office 48 hours prior to old well workover or re-entry.
5. Prior to plugging, prepare a plugging plan, then obtain agreement from the appropriate district office for an approved plugging plan.
6. Submit plugging report (CP-4) to K.C.C. after plugging is completed.
7. Obtain an approved injection docket number before disposing of salt water.
8. Notify K.C.C. within 10 days when injection commences or terminates.
9. If an alternate 2 completion, cement in the production pipe from below any usable water to surface within 120 days of spud date.

RECEIVED
 STATE CORPORATION COMMISSION

DEC 14 1984

CONSERVATION DIVISION
 Wichita, Kansas

12-14-84

**State Corporation Commission of Kansas
 Conservation Division
 200 Colorado Derby Building
 Wichita, Kansas 67202
 (316) 263-3238**