

CARD MUST BE TYPED

State of Kansas
NOTICE OF INTENTION TO DRILL
(see rules on reverse side)

~~CORRECTIONS~~

CARD MUST BE SIGNED
1-25-85

Starting Date: 2 1 85
month day year

API Number 15- 163-22,591-00-00

OPERATOR: License # ... 8925

C. N/2 N/2 NW Sec. 21 Twp. 6 S, Rge 20
(location) East West

Name .. Liberty Operations & Completions, Inc.

Address 308 West Mill

... 4950 Ft North from Southeast Corner of Section

City/State/Zip ... Plainville, KS 67663

... 3960 Ft West from Southeast Corner of Section

Contact Person David L. Comeau

(Note: Locate well on Section Plat on reverse side)

Phone ... (913) 434-4686

Nearest lease or unit boundary line 330 feet.

CONTRACTOR: License # ... 5665

County Rooks

Name Pioneer Drilling Company, Inc.

Lease Name Fischli Well# ... 3

City/State ... Plainville, Kansas

Domestic well within 330 feet : yes no

Well Drilled For: Well Class: Type Equipment:

Municipal well within one mile : yes no

Oil Swd Infield Mud Rotary

Depth to Bottom of fresh water 65 feet

Gas Inj Pool Ext. Air Rotary

Lowest usable water formation Dakota

OWWO Expl Wildcat Cable

Depth to Bottom of usable water 1175 feet

If OWWO: old well info as follows:

Surface pipe by Alternate : 1 2

Operator

Surface pipe to be set 250 feet

Well Name

Conductor pipe if any required N/A feet

Comp Date Old Total Depth

Ground surface elevation feet MSL

Projected Total Depth 3720 feet

This Authorization Expires 6-14-85

Projected Formation at TD ... Arbuckle

Approved By ~~David L. Comeau~~ 12-14-84

Expected Producing Formations Arbuckle

I certify that we will comply with K.S.A. 55-101, et seq., plus eventually plugging hole to K.C.C. specifications.


Date 1-25-85 Signature of Operator or Agent *David L. Comeau*

Title *Superintendent*

**Must be filed with the K.C.C. five (5) days prior to commencing well
This card void if drilling not started within six (6) months of date received by K.C.C.**

Important procedures to follow :

**A Regular Section of Land
1 Mile = 5,280 Ft.**

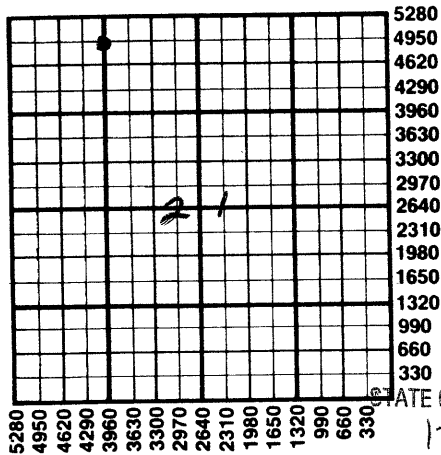

1. Notify District office before setting surface casing.
2. Set surface casing by circulating cement to the top.
3. File completion forms ACO-1 with K.C.C. within 90 days of well completion, following instructions on ACO-1, side 1, and including copies of wireline logs.
4. Notify District office 48 hours prior to old well workover or re-entry.
5. Prior to plugging, prepare a plugging plan, then obtain agreement from the appropriate district office for an approved plugging plan.
6. Submit plugging report (CP-4) to K.C.C. after plugging is completed.
7. Obtain an approved injection docket number before disposing of salt water.
8. Notify K.C.C. within 10 days when injection commences or terminates.
9. If an alternate 2 completion, cement in the production pipe from below any usable water to surface within 120 days of spud date.

RECEIVED
STATE CORPORATION COMMISSION

1-24-85
JAN 24 1985

CONSERVATION DIVISION
Wichita, Kansas

State Corporation Commission of Kansas
Conservation Division
200 Colorado Derby Building
Wichita, Kansas 67202
(316) 263-3238