

15-163-21646-00-00


STATE OF KANSAS
STATE CORPORATION COMMISSION

WELL PLUGGING RECORD

Give All Information Completely
Make Required Affidavit
Mail or Deliver Report to
Conservation Division
State Corporation Comm.
245 North Water
Wichita, KS 67202

Rooks County. Sec. 7 Twp. 6s Rge. 20wE/W
Location as "NE/CNW $\frac{1}{4}$ /SW $\frac{1}{4}$ " or footage from lines
NW NE NE

Lease Owner Lawbanco Drilling, Inc.
Lease Name McClurg Well No. 1
Office Address Box 289 Natoma, Kansas 67651
Character of Well (Completed as Oil, Gas or Dry Hole)
dry hole

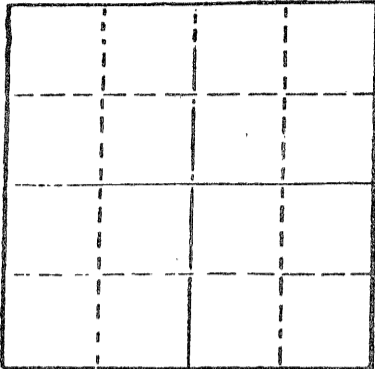

Locate well correctly on above
Section Plat

Date Well completed 7-1-82 19
Application for plugging filed 7-1-82 19
Application for plugging approved 7-1-82 19
Plugging commenced 6:20 P.M. 7-1-82 19
Plugging completed 7:45 P.M. 7-1-82 19
Reason for abandonment of well or producing formation
dry

If a producing well is abandoned, date of last production
19

Was permission obtained from the Conservation Division or
its agents before plugging was commenced? yes

Name of Conservation Agent who supervised plugging of this well Dennis Hamel
Producing formation _____ Depth to top _____ Bottom _____ Total Depth of Well _____
Show depth and thickness of all water, oil and gas formations.

OIL, GAS OR WATER RECORDS

CASING RECORD

FORMATION	CONTENT	FROM	TO	SIZE	PUT IN	PULLED OUT

Describe in detail the manner in which the well was plugged, indicating where the mud fluid was placed and the method or methods used in introducing it into the hold. If cement or other plugs were used, state the character of same and depth placed, from _____ feet to _____ feet for each plug set.

70 sacks at 900'
40 sacks at 225'
10 sacks at 40' with 1/2 sack hulls and plug for solid bridge
10 sacks rat hole
Total 130 sacks 50/50 poz 4% gel 3% cc

(If additional description is necessary, use BACK of this sheet)

Name of Plugging Contractor Lawbanco Drilling, Inc.
Box 289 Natoma, Kansas 67651

STATE OF Kansas COUNTY OF Os borne, ss.
R. L. Finnesy (employee of owner) or (owner or operator)
of the above-described well, being first duly sworn on oath, says: That I have knowledge of the facts, statements, and matters herein contained and the log of the above-described well as filed and that the same are true and correct. So help me God.

(Signature) R. L. Finnesy
2220 Marjorie Hays, Kansas 67601
(Address)

SUBSCRIBED AND SWORN TO before me this 19th day of July, 1982

My commission expires _____



Vivian A. Mapes Notary Public.

RECEIVED
STATE CORPORATION COMMISSION

JUL 21 1982
7-21-82
CONSERVATION DIVISION
Wichita, Kansas