

15-163-01067-00-00

STATE OF KANSAS
STATE CORPORATION COMMISSION

Form CP-4

WELL PLUGGING RECORD

Give All Information Completely
Make Required Affidavit
Mail or Deliver Report to:
Conservation Division
State Corporation Commission
211 No. Broadway
Wichita, Kansas

Rooks County, Sec. 8 Twp 6S Rge. (E) 20 (W)

Location as "NE/CNW/SW" or footage from lines SW SW SE

Lease Owner Chief Drilling Co., Inc.

Lease Name BRUMBAUGH Well No. 1

Office Address Box 797 - Gt. Bend, Kansas

Character of Well (completed as Oil, Gas or Dry Hole) Dry Hole

Date well completed 5/21 19 64

Application for plugging filed 5/21 19 64

Application for plugging approved 5/21 19 64


Plugging commenced 5/21 19 64

Plugging completed 5/21 19 64

Reason for abandonment of well or producing formation Dry Hole

If a producing well is abandoned, date of last production 19

Was permission obtained from the Conservation Division or its agents before plugging was commenced? Yes

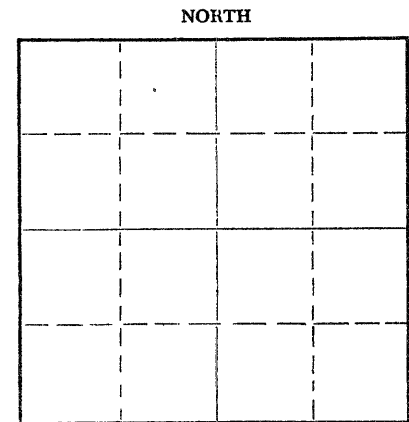

Locate well correctly on above
Section Plat

Name of Conservation Agent who supervised plugging of this well Eldon Petty - Hays, Kansas

Producing formation Depth to top Bottom Total Depth of Well 3655 Feet

Show depth and thickness of all water, oil and gas formations.

OIL, GAS OR WATER RECORDS

CASING RECORD

FORMATION	CONTENT	FROM	TO	SIZE	PUT IN	PULLED OUT
		0	195'	8-5/8"	195'	None

Describe in detail the manner in which the well was plugged, indicating where the mud fluid was placed and the method or methods used in introducing it into the hole. If cement or other plugs were used, state the character of same and depth placed, from feet to feet for each plug set.

Wooden plug set @ 480'
Mixed 20 sacks cement through drill pipe
Wooden plug set @ 180'
Mixed 20 sacks cement through drill pipe
1/2 sack hulls and wooden plug set @ 40'
Mixed 10 sacks cement through drill pipe

RECEIVED
STATE CORPORATION COMMISSION

MAY 27 1964

5-27-64

CONSERVATION DIVISION
Wichita, Kansas

(If additional description is necessary, use BACK of this sheet)

Name of Plugging Contractor Chief Drilling Co., Inc.

Address Box 797 - Gt. Bend, Kansas

STATE OF Kansas, COUNTY OF Barton, ss.

V. Richard Hoover, President (employee of owner) or (owner or operator) of the above-described

well, being first duly sworn on oath, says: That I have knowledge of the facts, statements, and matters herein contained and the log of the above-described well as filed and that the same are true and correct. So help me God.

(Signature) V. Richard Hoover CHIEF DRILLING CO., INC.

Box 797 - Gt. Bend, Kansas (Address)

SUBSCRIBED AND SWORN to before me this 25th day of May, 19 64

My commission expires Jan. 26, 1967

Carmen R. Cook, Notary Public.