

WELL PLUGGING RECORD

Give All Information Completely
Make Required Affidavit
Mail or Deliver Report to
Conservation Division
State Corporation Comm.
200 Colorado Derby Bldg.
202 W. 1st St.
Wichita, KS 67202

Rooks County Sec. 11 Twp. 6s Rge. 20 ~~E~~/W
Location as "NE/CNW/SW" or footage from lines _____


NE SE NE

Lease Owner Liberty Enterprises Inc.

Lease Name Simons Well No. #1

Office Address 308 W. Mill Plainville, Kansas 67663

Character of Well (Completed as Oil, Gas or Dry Hole) _____
Dry Hole

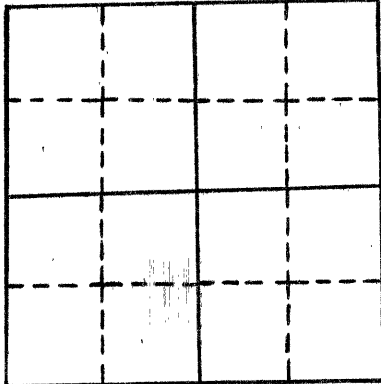

locate well correctly
on above
Section Plot

Date Well completed 3-20 19 83

Application for plugging filed 3-20 19 83

Application for plugging approved 3-20 19 83

Plugging commenced 9:45 AM 3-20 19 83

Plugging completed 10:30 AM 3-20 19 83

Reason for abandonment of well or producing formation _____
No Commercial Production

If a producing well is abandoned, date of last production _____
19 _____

Was permission obtained from the Conservation Division or its agents before plugging was commenced? Yes

Name of Conservation Agent who supervised plugging of this well Marion Schmidt

Producing formation _____ Depth to top _____ Bottom _____ Tl. Depth of Well _____

Show depth and thickness of all water, oil and gas formations.

OIL, GAS OR WATER RECORDS

CASING RECORD

FORMATION	CONTENT	FROM	TO	SIZE	PUT IN	PULLED OUT
surface casing	60-40 pos	0'	325'	8 5/8"	325'	0'

Describe in detail the manner in which the well was plugged, indicating where the mud fluid was placed and the method or methods used in introducing it into the hold. If cement or other plugs were used, state the character of same and depth placed, from _____ feet to _____ feet for each plug set.

Plug #1 1676' with 20 sxs

Plug #2 934' with 80 sxs

Plug #3 370' with 40 sxs

Plug #4 40' with 10 sxs

10 sxs in rathole

Total----- 160 sxs 50-50 pos 4%gel 3%cc

P.D. 10:30 AM 3-20-83

(If additional description is necessary, use BACK of this sheet)

Name of Plugging Contractor Pioneer Drilling Company
308 W. Mill Plainville, Kansas 67663

STATE OF Kansas COUNTY OF Rooks, ss.

Charles G. Comeau (employee of owner) or (owner or operator) of the above described well, being first duly sworn on oath, says: That I have knowledge of the facts, statements, and matters herein contained and the log of the above described well is filed and that the same are ~~correct~~ and correct. So help me God.


STATE CORPORATION COMMISSION

(Signature) [Signature]

(Address) 308 W. Mill Plainville, Ks. 67663

MAR 31 1983
3-31-83
CONSERVATION DIVISION
Wichita, Kansas

SUBSCRIBED AND SWORN TO before me this 30th day of March, 19 83

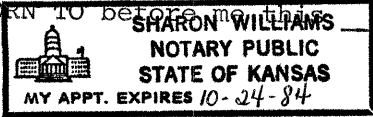

My commission expires _____

Sharon Williams
Notary Public