

WELL PLUGGING RECORD

Give All Information Completely
Make Required Affidavit
Mail or Deliver Report to
Conservation Division
State Corporation Comm.
200 Colorado Derby Bldg.
202 W. 1st St.
Wichita, KS 67202

Rooks County Sec. 16 Twp. 6S Rge. 20 E/W
Location as "NE/CNW/SW" or footage from lines
SW SW SE

Lease Owner Geodessa Corp.
Lease Name Nichol A Well No. #2
Office Address 1125 -17th Street Suite 2220 Denver, Co. 80202
Character of Well (Completed as Oil, Gas or Dry Hole) Dry Hole


Date Well completed July 25 19 81
Application for plugging filed July 25 19 81
Application for plugging approved July 25 19 81
Plugging commenced 5:00 P.M. July 25 19 81
Plugging completed 10:30 P.M. July 25 19 81

Reason for abandonment of well or producing formation
No Commercial Production

If a producing well is abandoned, date of last production 19

Was permission obtained from the Conservation Division or its agents before plugging was commenced? Yes

Name of Conservation Agent who supervised plugging of this well Marion Schmidt
Producing formation Depth to top Bottom Tl. Depth of Well
Show depth and thickness of all water, oil and gas formations.

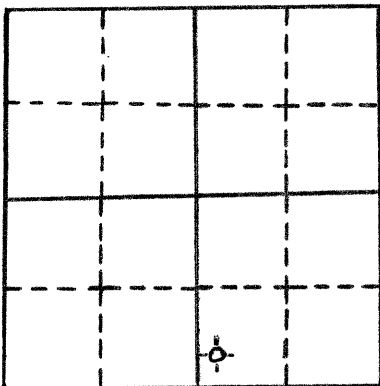

locate well correctly
on above
Section Plot

OIL, GAS OR WATER RECORDS

CASING RECORD

FORMATION	CONTENT	FROM	TO	SIZE	PUT IN	PULLED OUT
Surface casing	common	0'	251.77'	10 3/4"	251.77'	0'

Describe in detail the manner in which the well was plugged, indicating where the mud fluid was placed and the method or methods used in introducing it into the hold. If cement or other plugs were used, state the character of same and depth placed, from feet to feet for each plug set.

RECEIVED
STATE CORPORATION COMMISSION

AUG 14 1981

Plug #1 1160' with 65 sxs

Plug #2 220' with 30 sxs

Plug #3 40' with 10 sxs

5 sxs in rathole

Total - 110 sxs 50-50- pos 4% gel 3% cc

P.D. @ 10:30 July 25, 1981

CONSERVATION DIVISION
Wichita, Kansas

8-14-81

(If additional description is necessary, use BACK of this sheet)

Name of Plugging Contractor Pioneer Drilling Co, Inc.
308 West Mill Plainville, Ks 67663

X STATE OF COLORADO COUNTY OF DENVER, ss.

E. C. SCHUETT (employee of owner) or (contractor) operator of the above described well, being first duly sworn on oath, says: That I have knowledge of the facts, statements, and matters herein contained and the log of the above described well is filed and that the same are true and correct. So help me God.

(Signature) E. C. Schuett
(Address) 1125 - 17th St., Suite 2220
Denver, Colorado 80202

SUBSCRIBED AND SWORN TO before me this 12th day of August, 1981

My commission expires July 30, 1985

Deborah A. Lopez
Notary Public, Deborah A. Lopez

W E L L L O G

15-163-21345-06-06

OPERATOR: Geodessa Corp.

WELL NAME: Nichol A #2

LOCATION: SW SW SE 16-6S-20W

COUNTY: Rooks

STATE: Kansas

WELL COMMENCED: July 16, 1981

WELL COMPLETED: July 25, 1981

ELEVATION: 2164' G.L.

TOTAL DEPTH: 3722'

PRODUCTION: D & A

RIG NO: #4


CASING - ~~8 5/8"~~ 10 3/4": 6 Jts new 40# set @ 251.77 cemented with 250 sxs common 2% gel 3% cc
5 1/2": P.D. @ 11:45 P.M. did circ

ALL MEASUREMENTS TAKEN FROM THE TOP OF ROTARY BUSHING:

FROM	TO	FORMATION	DEVIATION FROM VERTICAL	REMARKS:
0'	262'	sand and clay	262' - 3/4 degree	
262'	634'	shale and sand		
634'	1158'	shale and sand		
1158'	1309'	shale and sand		
1309'	1789'	shale and sand		
1789'	1790'	shales		
1790'	1825'	anhydrite		
1825'	2130'	shales		
2130'	2178'	shales	2178' - 1 3/4 degree	
2178'	2200'	shales		
2200'	2492'	shales		
2492'	2772'	shales		
2772'	2963'	shales		
2963'	3151'	shale and lime		
3151'	3300'	shale and lime		
3300'	3415'	lime and shale		
3415'	3504'	shale and lime	3504' - 1 1/4 degree	
3504'	3579'	shale and lime		
3579'	3669'	lime		
3669'	3673'	arbuckle		
3673'	3682'	arbuckle and sand		
3682'	3700'	arbuckle and sand		
3700'	3722'	arbuckle and sand		
3722'		R.T.D.		

STATE OF KANSAS
COUNTY OF

The undersigned hereby certifies that to the best of his knowledge and belief, the above facts are true and correct

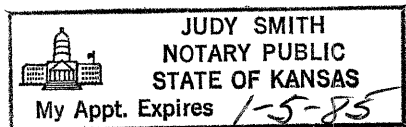

PIONEER DRILLING CO., INC.

By Stacy A. Hilgus

SUBSCRIBED AND SWORN TO, BEFORE ME, This 27th day of July, 19 81

Judy Smith
NOTARY PUBLIC

RECEIVED
STATE CORPORATION COMMISSION
7-30-81
JUL 30 1981
CONSERVATION DIVISION
Wichita, Kansas