

WELL PLUGGING RECORD

Give All Information Completely
Make Required Affidavit
Mail or Deliver Report to
Conservation Division
State Corporation Comm.
245 North Water
Wichita, KS 67202

Rooks _____ County Sec. 16 Twp. 6s Rge. 20 EW
Location as "NE/CNW/SW" or footage from lines _____
C SW SE

Lease Owner Geodessa Corporation
Lease Name Nichols "A" Well No. #1
Office Address 1125 17th St. Suite 2220 Denver, CO 80202

Character of Well (Completed as Oil, Gas or Dry Hole) _____
Dry Hole

Date Well completed June 5, 1981

Application for plugging filed June 5 1981

Application for plugging approved June 5 1981

Plugging commenced 7:00 P.M. June 5, 1981

Plugging completed 8:40 P.M. June 5 1981


Reason for abandonment of well or producing formation _____
No Commercial Production

If a producing well is abandoned, date of last production _____
19 _____

Was permission obtained from the Conservation Division or
its agents before plugging was commenced? yes

Name of Conservation Agent who supervised plugging of this well Marion Schmidt
Producing formation _____ Depth to top _____ Bottom _____ Tl. Depth of Well 3181
Show depth and thickness of all water, oil and gas formations.

locate well correctly
on above
Section Plot

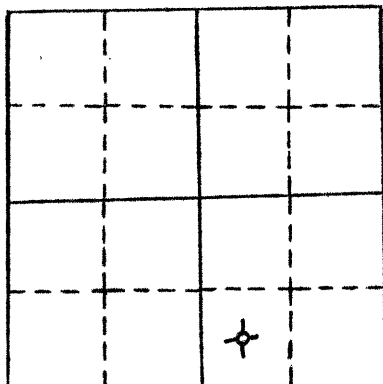

OIL, GAS OR WATER RECORDS

CASING RECORD

FORMATION	CONTENT	FROM	TO	SIZE	PUT IN	PULLED OUT
Surface Casing	common	0'	210.5'	8 5/8"	210.5'	0'

Describe in detail the manner in which the well was plugged, indicating where the mud fluid was placed and the method or methods used in introducing it into the hold. If cement or other plugs were used, state the character of same and depth placed, from _____ feet to _____ feet for each plug set.

Plug #1 @ 1080' with 65 sxs

Plug #2 @ 240' with 30 sxs

Plug #3 @ 40' with 10 sxs solid bridge 2 sxs hulls

5 sxs in rathole

Total 110 sxs common 2% gel 3% cc

(If additional description is necessary, use BACK of this sheet)

Name of Plugging Contractor Pioneer Drilling Company, Inc.
308 West Mill Plainville, KS 67663

STATE OF COLORADO COUNTY OF DENVER, ss.

E. C. Schuett (employee of owner) or (owner or operator) of the above described well, being duly sworn on oath, says: That I have knowledge of the facts, statements, and matters herein contained and the log of the above described well is filed and that the same are true and correct. So help me God.

RECEIVED
STATE CORPORATION COMMISSION
JUN 19 1981
6-19-81 (Signature) E. C. Schuett
E. C. Schuett
Wichita, Kansas (Address) 1125 - 17th Street, Suite 2220
Denver, Colorado 80202

SUBSCRIBED AND SWORN TO before me this 12th day of June, 19 81

My commission expires July 27, 1981

Deborah A. Lopez
Notary Public
Deborah A. Lopez

15-163-21210-00-00

W E L L L O G

OPERATOR: Geodessa Corporation

WELL NAME: Nichols "A" #1 LOCATION: C SW SE 16-6s-20W

COUNTY: Rooks STATE: Kansas

WELL COMMENCED: May 27, 1981 WELL COMPLETED: June 6, 1981

ELEVATION: 2178' GL TOTAL DEPTH: 3181'

PRODUCTION: D & A RIG NO: #4

CASING - 8 5/8": 210.5' new 24# cemented with 100 sxs common 3% cc 2% gel did circ
5 1/2":

ALL MEASUREMENTS TAKEN FROM THE TOP OF ROTARY BUSHING:

FROM	TO	FORMATION	DEVIATION FROM VERTICAL	REMARKS:
0'	210'			
210'	214'	cement		
214'	954'	sand and shale		
954'	1164'	sand and shales		
1164'	1411'	sand and shale		
1411'	1487'	sand and shale		
1487'	1503'	sand and shales		
1503'	2148'	shale, sand, Anhydrite	1900' - 1 3/4 - degree	
1789'	1825'	Anhydrite		
2148'	2279'	shales	2279' - 1 1/4 - degree	
2279'	2344'	shales		
2344'	2622'	shales		
2622'	2899'	shale and lime		
2899'	3106'	shale and lime		
3106'	3181'	shale and lime		
3181'	RTD			


RECEIVED
STATE CORPORATION COMMISSION

JUN 10 1981

CONSERVATION DIVISION
Wichita, Kansas

STATE OF KANSAS
COUNTY OF

The undersigned hereby certifies that to the best of his knowledge and belief, the above facts are true and correct

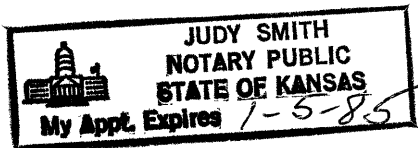

PIONEER DRILLING CO., INC.

By Connie Jo Austin

SUBSCRIBED AND SWORN TO, BEFORE ME, This 9th day of June, 1981

Judy Smith
NOTARY PUBLIC