


15-163-20958-00-00

STATE OF KANSAS
STATE CORPORATION COMMISSION

WELL PLUGGING RECORD

Give All Information Completely
Make Required Affidavit
Mail or Deliver Report to
Conservation Division
State Corporation Comm.
245 North Water
Wichita, KS 67202

Rooks County, Sec. 18 Twp. 6S Rge. 20W #/W
Location as "NE/CNW $\frac{1}{4}$ SW $\frac{1}{4}$ " or footage from lines
420' S & 20' E of C NE/4 SE/4
Lease Owner Gear Petroleum Company
Lease Name Hicks "A" Well No. 2
Office Address 300 Sutton Place, Wichita, Kansas 67202
Character of Well (Completed as Oil, Gas or Dry Hole) D & A
Date Well completed August 5, 1979
Application for plugging filed August 5, 1979
Application for plugging approved August 5, 1979
Plugging commenced August 5, 1979
Plugging completed August 5, 1979
Reason for abandonment of well or producing formation D & A

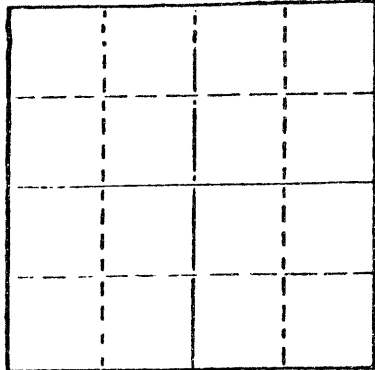

Locate well correctly on above
Section Plat

If a producing well is abandoned, date of last production 19
Was permission obtained from the Conservation Division or
its agents before plugging was commenced? Yes

Name of Conservation Agent who supervised plugging of this well Leo F. Massey
Producing formation _____ Depth to top _____ Bottom _____ Total Depth of Well 3,941'
Show depth and thickness of all water, oil and gas formations.

OIL, GAS OR WATER RECORDS

CASING RECORD

FORMATION	CONTENT	FROM	TO	SIZE	PUT IN	PULLED OUT
				13 3/8"	176.65'	-0-

Describe in detail the manner in which the well was plugged, indicating where the mud fluid was placed and the method or methods used in introducing it into the hold. If cement or other plugs were used, state the character of same and depth placed, from _____ feet to _____ feet for each plug set.

- 1st Plug @ 1,150' w/60 sx cement
- 2nd Plug @ 180' w/50 sx cement
- 3rd Plug @ 40' w/20 sx cement
- 5 sx cement in rathole
- Cement was 50/50 Pozmix

RECEIVED
STATE CORPORATION COMMISSION

AUG 14 1979

(If additional description is necessary, use BACK of this sheet)

Name of Plugging Contractor Red Tiger Drilling Company
1720 KSB&T Building, Wichita, Kansas 67202

8-14-79
STATE CORPORATION COMMISSION
Wichita, Kansas


STATE OF Kansas COUNTY OF Sedgwick, ss. contractor
Gloria Fawcett (employee of ~~owner~~)

of the above-described well, being first duly sworn on oath, says: That I have knowledge of the facts, statements, and matters herein contained and the log of the above-described well as filed and that the same are true and correct. So help me God.

(Signature) Gloria Fawcett
1720 KSB&T Building, Wichita, Kansas 67202
(Address)

SUBSCRIBED AND SWORN TO before me this 9th day of August, 1979.

My commission expires _____
Joyce A. Hagermann Notary Public.

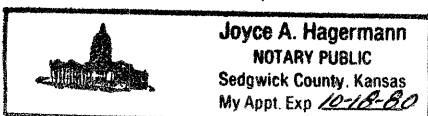

DRILLERS LOG

15-163-20958-00-00

No. 2 Hicks "A"

CASING RECORD:
13 3/8" @ 184'
w/230 sx cement

COMPANY: Gear Petroleum Company
CONTRACTOR: Red Tiger Drilling Company
COMMENCED: July 28, 1979
COMPLETED: August 5, 1979

DESCRIPTION:
420' S & 20' E of C NE/4 SE/4
Sec. 18-T6S-R20W
Rooks County, Kansas

TOTAL DEPTH: 3,941'

ELEVATION: 2,224' KB

<u>FORMATION</u>	<u>FROM</u>	<u>TO</u>	<u>REMARKS</u>
Sand	0	60	
Shale & Sand	60	220	
Sand	220	465	
Shale	465	777	
Sand & Shale	777	1100	
Shale & Red Bed	1100	1351	
Sand	1351	1565	
Lime & Red Bed	1565	1650	
Red Bed & Shale	1650	1849	
Anhydrite	1849	1881	
Shale	1881	2350	
Shale & Lime Streaks	2350	2456	
Shale & Lime	2456	2670	
Sand	2670	2688	
Shale & Lime	2688	2838	
Shale & Sand	2838	3035	
Lime & Shale	3035	3175	
Shale & Lime	3175	3445	
Lime	3445	3660	
Lime & Shale	3660	3760	
Lime	3760	3941	
RTD		3941	

I certify that this is a true and correct copy of the above log to the best of my knowledge.

RED TIGER DRILLING COMPANY

RECEIVED
STATE CORPORATION COMMISSION

Gloria Fawcett
Gloria Fawcett

AUG 14 1979

8-14-79
CONSERVATION DIVISION
Wichita, Kansas

Subscribed and sworn to before me this 9th day of August, 1979.

Joyce A. Hagermann
Notary Public

