


13-163-20024-00-00

Give All Information Completely
Make Required Affidavit
Mail or Deliver Report to:
Conservation Division
State Corporation Commission
212 No. Market
Wichita, Kansas

WELL PLUGGING RECORD

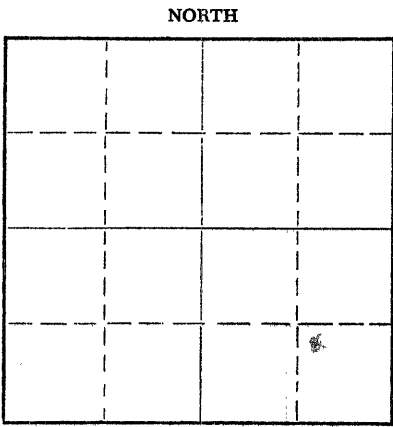

Locate well correctly on above Section Plat

Rooks County, Sec 4 Twp. 6S Rge. (E) 20 (W)
Location as "NE/CNW/SW" or footage from lines NE SE SE
Lease Owner Aladdin Petroleum Corp.
Lease Name Buss Well No. 1
Office Address 809 Petroleum Building - Wichita, Kansas
Character of Well (completed as Oil, Gas or Dry Hole) dry
Date well completed 5-30 1967
Application for plugging filed 5-30 1967
Application for plugging approved 5-31 19
Plugging commenced 9:30 PM 5-30 19
Plugging completed 6:30 AM 5-31 19
Reason for abandonment of well or producing formation dry

If a producing well is abandoned, date of last production none 19
Was permission obtained from the Conservation Division or its agents before plugging was commenced? yes

Name of Conservation Agent who supervised plugging of this well Leo Massey, Hays, Kansas
Producing formation none Depth to top Bottom Total Depth of Well 3629 Feet
Show depth and thickness of all water, oil and gas formations.

OIL, GAS OR WATER RECORDS

CASING RECORD

FORMATION	CONTENT	FROM	TO	SIZE	PUT IN	PULLED OUT
Shale		0	215	8 5/8"	208	0

Describe in detail the manner in which the well was plugged, indicating where the mud fluid was placed and the method or methods used in introducing it into the hole. If cement or other plugs were used, state the character of same and depth placed, from feet to feet for each plug set.

Plug hole - Set plug at 500' Cemented with 20 sacks through drill pipe
Filled hole to 210' set plug & 1/4 sack hulls. Cemented with 20 sacks
through drill pipe. Filled hole to 40' Bridge to hold kelly weight and
cemented with 8 sacks and 2 sacks in rat hole.

RECEIVED
STATE CORPORATION COMMISSION

JUN 5 1967

CONSERVATION DIVISION
Wichita, Kansas

6-5-67

(If additional description is necessary, use BACK of this sheet)

Name of Plugging Contractor B & B Drilling, Inc.
Address 548 Petroleum Building - Wichita, Kansas

STATE OF Kansas, COUNTY OF Sedgwick, ss.
Bill Lahar (employee of owner) or (owner or operator) of the above-described well, being first duly sworn on oath, says: That I have knowledge of the facts, statements, and matters herein contained and the log of the above-described well as filed and that the same are true and correct. So help me God.

(Signature) Bill Lahar
548 Petroleum Building - Wichita, Kansas
(Address)

SUBSCRIBED AND SWORN TO before me this 2nd day of June, 19 67

My commission expires May 31, 1970

Alma A. Neises
Notary Public.