

15-163-20326-00-00


STATE OF KANSAS
STATE CORPORATION COMMISSION

Form CP-4

WELL PLUGGING RECORD

Give All Information Completely
Make Required Affidavit
Mail or Deliver Report to:
Conservation Division
State Corporation Commission
212 No. Market
Wichita, Kansas 67202

NORTH

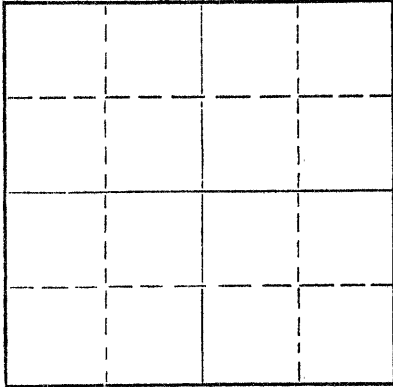

Locate well correctly on above
Section Plat

Rooks County. Sec. 4 Twp. 6S Rge. 20 (E) W (W)
Location as "NE/CNW/SW" or footage from lines NW NE SE
Lease Owner Glen N. Rupe
Lease Name Witt Well No. 1
Office Address 222 Brown Building, Wichita, Kansas
Character of Well (completed as Oil, Gas or Dry Hole) D&A
Date well completed October 2, 1970
Application for plugging filed October 2, 1970
Application for plugging approved October 2, 1970
Plugging commenced October 2, 1970
Plugging completed October 2, 1970
Reason for abandonment of well or producing formation D&A

If a producing well is abandoned, date of last production _____ 19____
Was permission obtained from the Conservation Division or its agents before plugging was commenced? Yes

Name of Conservation Agent who supervised plugging of this well Leo Massey
Producing formation _____ Depth to top _____ Bottom _____ Total Depth of Well 3607 Feet
Show depth and thickness of all water, oil and gas formations.

OIL, GAS OR WATER RECORDS

CASING RECORD

FORMATION	CONTENT	FROM	TO	SIZE	PUT IN	PULLED OUT
				8 5/8"	202.09'	-0-

Describe in detail the manner in which the well was plugged, indicating where the mud fluid was placed and the method or methods used in introducing it into the hole. If cement or other plugs were used, state the character of same and depth placed, from _____ feet to _____ feet for each plug set.

Plug @ 800' w/70 sx cement
Plug @ 180' w/20 sx cement
Plug @ 40' w/10 sx cement

RECEIVED
STATE CORPORATION COMMISSION
OCT 8 1970
CONSERVATION DIVISION
Wichita, Kansas
10-8-70


(If additional description is necessary, use BACK of this sheet)

Name of Plugging Contractor Red Tiger Drilling Company
Address 1720 Wichita Plaza, Wichita, Kansas 67202

STATE OF Kansas, COUNTY OF Sedgwick, ss.
Jim Farrice (employee of owner) or (owner or operator) of the above-described

well, being first duly sworn on oath, says: That I have knowledge of the facts, statements, and matters herein contained and the log of the above described well as filed and that the same are true and correct. So help me God.

(Signature) Jim Farrice
1720 Wichita Plaza, Wichita, Kansas
(Address)

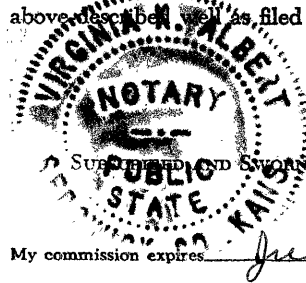

Subscribed and sworn to before me this 5 day of October, 19 70
Virginia K. Althoff
Notary Public.

DRILLERS LOG

No. 1 Witt

CASING RECORD:

8 5/8" @ 209'
w/150 ex cement

COMPANY:

Glen N. Rupe

DESCRIPTION:

NW NE SE
4-68-20W
Rooks County,
Kansas

CONTRACTOR:

Red Tiger Drilling Company

COMMENCED:

September 22, 1970

COMPLETED:

October 2, 1970

TOTAL DEPTH: 3607'

ELEVATION:

<u>FORMATION</u>	<u>FROM</u>	<u>TO</u>	<u>REMARKS</u>
Sod, Clay	0	140	
Shale	140	1255	
Sand	1255	1435	
Shale	1435	1490	
Shale & Shells	1490	1706	
Anhydrite	1706	1736	
Shale & Lime	1736	3185	
Lime	3185	3543	
Cong. Shale	3543	3561	
Lime	3561	3587	
Lime & Sand	3587	3607	

I certify that this is a true and correct copy of the above log to the best of my knowledge.

RED TIGER DRILLING COMPANY

Jim Farrice
Jim Farrice

Subscribed and sworn to before me this 5 day of October, 1970.

Virginia A. Albert
Notary Public

My Commission Expires:

July 23, 1974

