


WELL PLUGGING RECORD

TS-103-21817-00-00

Give All Information Completely
 Make Required Affidavit

COUNTY Rooks SEC. 6 TWP. 6S RGE. 20 E/W
 Location as in quarters or footage from lines:
100' N of SE SE NW

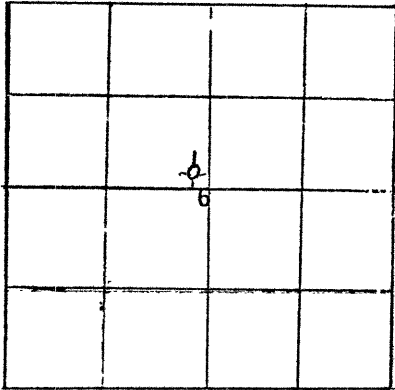

Locate Well
 correctly on above
 Section Platt.

Lease Owner Petroleum Management, Inc.
 Lease Name Vehige Well No. 1
 Office Address 400 N. Woodlawn, Suite 201, Wichita, KS 67208
 Character of Well (Completed as Oil, Gas or Dry Hole): D&A
 Date Well Completed November 16, 1982
 Application for plugging filed November 15, 1982
 Plugging commenced November 16, 1982
 Plugging completed November 16, 1982
 Reason for abandonment of well or producing formation D&A

Was permission obtained from the Conservation Division or it's
 Agent's before plugging was commenced? Yes

Name of Conservation Agent who supervised plugging of this well R.D. Reber, Jr.

Producing formation _____ Depth to top _____ bottom _____ T.D. 3101'

Show depth and thickness of all water, oil and gas formations.

OIL, GAS OR WATER RECORDS

Casing Record

Formation	Content	From	To	Size	Put in	Pulled Out
				8-5/8"	374'	-0-

Describe in detail the manner in which the well was plugged, indicating where the mud
 fluid was placed and the method or methods used in introducing it into the hold. If cement
 or other plugs were used, state the character of same and depth placed, from _____ feet
 to _____ feet for each plug set.

Hole plugged:

- 20 sx @ 1590'
- 100 sx @ 990'
- 40 sx @ 390'
- 10 sx @ 40' w/1 sx hull=1 plug solid bridge
- 10 sx in rathole
- 180 sx of 50-50 poz, 6% Gel., 3% C.C.

RECEIVED
 STATE CORPORATION COMMISSION
 DEC 3 1982
 CONSERVATION DIVISION
 Wichita Kansas
 12-3-82


(If additional description is necessary, use BACK of this sheet)

Name of Plugging Contractor Allied Cementing Comapny
Box 32, 331 W. Wichita, Russell, KS 67665

STATE OF KANSAS COUNTY OF SEDGWICK, ss.
Dale Silcott (employee of owner) or (owner or operator) of the
 above-described well, being first duly sworn on oath, says: That I have knowledge of the
 facts, statements, and matters herein contained and the log of the above-described well as
 filed and that the same are true and correct. So help me God.

(Signature) Dale Silcott
400 N. Woodlawn, Suite 201
Wichita, (Address) KS 67208

SUBSCRIBED AND SWORN TO before me this 2nd day of Dec., 19 82

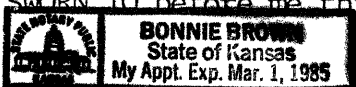

Bonnie Brown
 Notary Public.

My Commission expires March 1, 1985