

15-163-66378-00-00


STATE OF KANSAS  
STATE CORPORATION COMMISSION

Give All Information Completely  
Make Required Affidavit  
Mail or Deliver Report to:  
Conservation Division  
State Corporation Commission  
800 Bitting Building  
Wichita, Kansas

WELL PLUGGING RECORD

Rooks County, Sec. 7 Twp. 6 Rge. (E) 20 (W)  
Location as "NE/CNW $\frac{1}{4}$ /SW $\frac{1}{4}$ " or footage from lines SE $\frac{1}{4}$  SE $\frac{1}{4}$  NW $\frac{1}{4}$  SW  
Lease Owner Barnett Drilling, Inc., et al  
Lease Name Nichol Well No. 1  
Office Address 623 First National Bank Building, Wichita, Kansas  
Character of Well (completed as Oil, Gas or Dry Hole) Dry Hole  
Date well completed December 21, 1951  
Application for plugging filed December 21, 1951  
Application for plugging approved December 21, 1951  
Plugging commenced December 21, 1951  
Plugging completed December 21, 1951  
Reason for abandonment of well or producing formation Dry Hole

NORTH

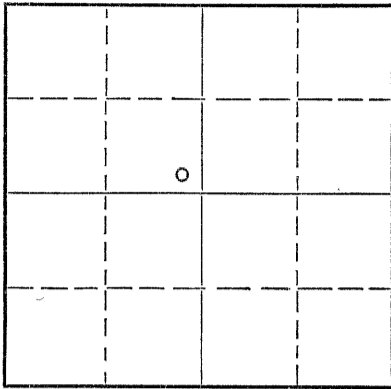

Locate well correctly on above  
Section Plat

If a producing well is abandoned, date of last production 19  
Was section obtained from the Conservation Division or its agents before plugging was commenced? Yes

Name of Conservation Agent who supervised plugging of this well Elden Petty  
Producing formation Depth to top Bottom Total Depth of Well 3761 Feet  
Show depth and thickness of all water, oil and gas formations.


OIL, GAS OR WATER RECORDS

CASING RECORD

Formation	Content	From	To	Size	Put In	Pulled Out
Surface Pipe		0	175'	8 5/8"	175'	None

Describe in detail the manner in which the well was plugged, indicating where the mud fluid was placed and the method or methods used in introducing it into the hole. If cement or other plugs were used, state the character of same and depth placed, from feet to feet for each plug set.

Filled hole with heavy mud from 3761 feet to 170 feet. Set wooden plug at 170 ft. Filled with one-half sack of hulls and 15 sacks of cement to 120 feet. Filled with heavy mud to 40 feet and set wooden plug at 40 feet. Dumped 1/2 sack of hulls on plug and filled to bottom of cellar with 10 sacks of cement.

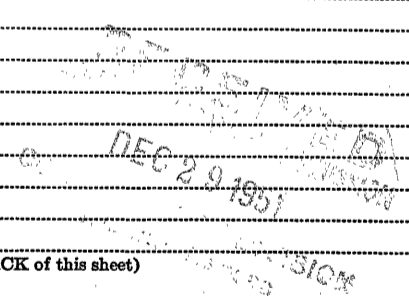

(If additional description is necessary, use BACK of this sheet)  
Name of Plugging Contractor Barnett Drilling, Inc.  
Address 623 First National Bank Building  
Wichita 2, Kansas

STATE OF Kansas, COUNTY OF Sedgwick, ss.  
E. R. Stubblefield (employee of owner) or (owner or operator) of the above-described well,  
being first duly sworn on oath, says: That I have knowledge of the facts, statements, and matters herein contained and the log of the above-described well as filed and that the same are true and correct. So help me God.

(Signature) *E. R. Stubblefield*  
623 First National Bank Building, Wichita, Kansas  
(Address)

SUBSCRIBED AND SWORN to before me this 28th day of December, 1951  
*Adelaide Oliver*  
Notary Public.

My commission expires May 12, 1955.

PLUGGING  
FILE NO. 716820  
PAGE 133 LINE 39

15-163-00378-00-00

BARNETT DRILLING, INC.  
LOG OF NICHOL WELL NO. 1  
SE 1/4 SE 1/4 NW 1/4 SECTION 7-6-20W, ROOKS COUNTY, KANSAS

DATE COMMENCED: December 13, 1951

DATE COMPLETED: December 21, 1951

Formation	From	To	Remarks
Surface Clay	0	110	Set 8 5/8" Surface Pipe @ 175 feet; cemented with 125 sacks.
Gravel	110	120	
Sandy Clay	120	140	
Shale	140	165	
Shale and Shells	165	175	
Shale	175	775	
Red Bed	775	875	
Shale	875	1175	
Shale and Shells	1175	1840	
Anhydrite	1840	1875	
Shale	1875	2200	
Shale and Shells	2200	2530	
Shale	2530	2625	
Lime and Shale	2625	2685	
Shale and Shells	2685	2785	
Shale and Lime	2785	3165	
Lime and Shale	3165	3340	
Shale and Lime	3340	3375	
Lime and Shale	3375	3450	
Lime	3450	3709	
Granite Wash	3709	3761	
Total Depth		3761	Dry and Abandoned.

Certificate.

I, F. R. Stubblefield, of Barnett Drilling, Inc., hereby certify that to the best of my knowledge and belief, the above is a true and correct log of the Nichol Well No. 1, located in the SE 1/4 SE 1/4 NW 1/4 of Section 7-6S-20W, Rooks County, Kansas.

*F. R. Stubblefield*  
\_\_\_\_\_

Subscribed and sworn to before me, in and for the County of Sedgwick, State of Kansas, this 28th day of December, 1951.

*Delaine Clinie*  
\_\_\_\_\_  
Notary Public

My commission expires May 12, 1955.

PLUGGING  
FILE SEC 7 T (6 R 22)  
BOOK PAGE 133 LINE 39

RECEIVED  
COMMISSION  
DEC 29 1951  
CONSERVATION DIVISION  
12-29-51

15-163-00378-00-00

BARNETT OIL COMPANY, ET AL  
LOG OF JAMES NICHOL WELL NO. 1  
SE<sup>1</sup>/<sub>4</sub> SE<sup>1</sup>/<sub>4</sub> SW<sup>1</sup>/<sub>4</sub> SECTION 7-6S-20W, ROOKS COUNTY, KANSAS

DATE COMMENCED: Dec. 13, 1951

DATE COMPLETED: Dec. 24, 1951

Formation	From	To	Remarks
Surface Clay	0	110	
Sandy Clay	110	140	
Shale	140	165	
Shale and Shells	165	175	
Shale	175	775	
Red Bed	775	875	
Shale	875	1175	
Shale and Shells	1175	1840	
Anhydrite	1840	1875	
Shale	1875	2200	
Shale and Shells	2200	2530	
Shale	2530	2685	
Shale and Shells	2685	2785	
Shale and Lime	2785	3450	
Lime	3450	3709	
Granite Wash	3709	3761	
Total Depth		3761	Dry and Abandoned

Set 8 5/8" 24# Surface Casing at 175 feet;  
Cemented with 125 Sacks of Cement.

Dry and Abandoned

PLUGGING  
FILE SEC 7-6-20W  
BOOK PAGE 133 LINE 39

VED  
JAN 11 1952 1-11-52