


STATE OF KANSAS
STATE CORPORATION COMMISSION

WELL PLUGGING RECORD

Give All Information Completely
Make Required Affidavit
Mail or Deliver Report to
Conservation Division
State Corporation Comm.
245 North Water
Wichita, KS 67202

Rooks County. Sec. 29 Twp. 6S Rge. 20 $\frac{1}{4}$ /W
Location as "NE/CNW $\frac{1}{4}$ SW $\frac{1}{4}$ " or footage from lines
NE SE SW
Lease Owner Cinco Exploration c/o Melvin Klotzman
Lease Name BENOIT Well No. 1
Office Address P.O. Box 3723, Victoria, TX 77901
Character of Well (Completed as Oil, Gas or Dry Hole)
Dry Hole
Date Well completed 4-21-79 19
Application for plugging filed 4-21-79 19
Application for plugging approved 4-21-79 19
Plugging commenced 4-21-79 19
Plugging completed 4-21-79 19
Reason for abandonment of well or producing formation

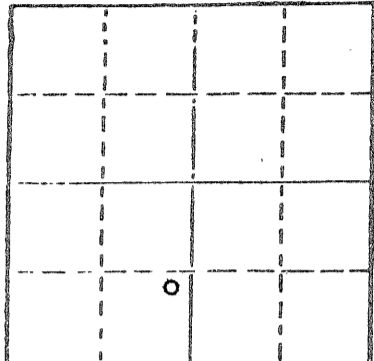

Locate well correctly on above Section Plat

Dry Hole
If a producing well is abandoned, date of last production 19
Was permission obtained from the Conservation Division or its agents before plugging was commenced? YES

Name of Conservation Agent who supervised plugging of this well Leo Massey
Producing formation _____ Depth to top _____ Bottom _____ Total Depth of Well 3951'
Show depth and thickness of all water, oil and gas formations.

OIL, GAS OR WATER RECORDS

CASING RECORD

FORMATION	CONTENT	FROM	TO	SIZE	PUT IN	PULLED OUT
				8-5/8"	255'	

Describe in detail the manner in which the well was plugged, indicating where the mud fluid was placed and the method or methods used in introducing it into the hold. If cement or other plugs were used, state the character of same and depth placed, from _____ feet to _____ feet for each plug set.

1st plug @ 900' w/70 sx.
2nd plug @ 240' w/20 sx.
3rd plug @ 40' w/10 sx.

(If additional description is necessary, use BACK of this sheet)

Name of Plugging Contractor _____

RECEIVED
STATE CORPORATION COMMISSION
MAY 22 1979

STATE OF Kansas COUNTY OF Sedgwick
Wayne Johnston, Production Mgr. of Murfin Drig. CO (employee of owner) or (owner or operator)
of the above-described well, being first duly sworn on oath, says: That I have knowledge of the facts, statements, and matters herein contained and the log of the above-described well as filed and that the same are true and correct. So help me God.

(Signature) Wayne Johnston
Wayne Johnston, Production Mgr.
617 Union Center Building, Wichita, Kansas 67202 (Address)

SUBSCRIBED AND SWORN TO before me this 21st day of May 5, 1979.

My commission expires _____

Kerran Lidia
Kerran Lidia - Notary Public.


KERRAN LIDIA
STATE NOTARY PUBLIC
SEDGWICK COUNTY, KANSAS
MY APPT. EXP. 2-6-82

WELL LOG 15-163-20898-00-00

COMPANY Cinco Exploration c/o Melvin Klotzman
FARM BENOIT **NO.** 1
RIG. NO. 15
TOTAL DEPTH 3951'
COMM. 4-14-79 **COMP.** 4-21-79
CONTRACTOR Murfin Drilling Company

SEC. 29 **T.** 6S **R.** 20W
LOC. NE SE SW

COUNTY Rooks, KANSAS

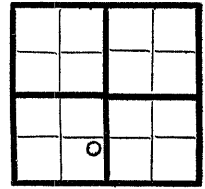

CASING
 20 10
 15 8- 5/8" csg. w/190 sx.
 12 6
 13 5

ELEVATION
PRODUCTION

FIGURES INDICATE BOTTOM OF FORMATIONS

255'	Surface Dirt & Shale
340'	Cement & Shale
1340'	Shale & Sand
1415'	Shale
1610'	Sand
1877'	Shale (Red Bed)
1915'	ANHYDRITE
2460'	Shale
3435'	Shale & Lime
3735'	Lime & Chert
3775'	Lime
3951'	Lime & Chert RTD

RECEIVED
 STATE COMMISSIONER OF GEOL. & NAT. RES.
 MAY 22 1970
 COMMERCIAL BUILDING
 TOPEKA, KANSAS

State of Kansas
 County of Sedgwick } ss:

I, Wayne Johnston, Production Mgr. of the Murfin Drilling Company Company
 upon oath state that the above and foregoing is a true and correct copy of the log of the BENOIT #1 well.

Subscribed and sworn to before me this 21st day of May 1970.
Wayne Johnston
Wayne Johnston, Production Mgr.

My Commission Expires:
 KERRAN LIDIA
 STATE NOTARY PUBLIC
 SEDGWICK COUNTY, KANSAS
 MY APPT. EXP. 2-28-82

Kerran Lidia
 Kerran Lidia - NOTARY PUBLIC