

15-163-21775-00-00

STATE OF KANSAS
STATE CORPORATION COMMISSION

WELL PLUGGING RECORD

Give All Information Completely
Make Required Affidavit
Mail or Deliver Report to
Conservation Division
State Corporation Comm.
245 North Water
Wichita, KS 67202

Rooks County, Sec. 27 Twp. 6 Rge. 20 E/W
Location as "NE/CNW $\frac{1}{4}$ SW $\frac{1}{4}$ " or footage from lines
C S/2 N/2

Lease Owner Kenny Brown Enterprises
Lease Name Johnston Well No. 1
Office Address P. O. Drawer 340, Plainville, KS 67663

Character of Well (Completed as Oil, Gas or Dry Hole)
Dry Hole


Date Well completed 9-18 1982
Application for plugging filed 9-18 1982
Application for plugging approved 9-18 1982
Plugging commenced 9-18 1982
Plugging completed 9-18 1982

Reason for abandonment of well or producing formation
DRY HOLE

If a producing well is abandoned, date of last production
19

Was permission obtained from the Conservation Division or
its agents before plugging was commenced? Yes

Name of Conservation Agent who supervised plugging of this well Marion Schmidt
Producing formation _____ Depth to top _____ Bottom _____ Total Depth of Well 3682'
Show depth and thickness of all water, oil and gas formations.

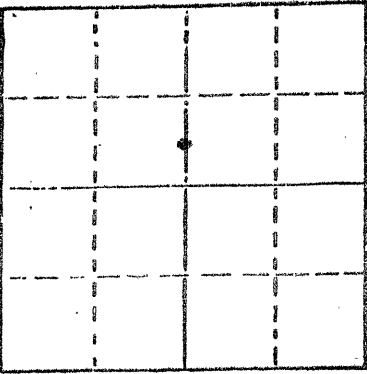

Locate well correctly on above
Section Plot

OIL, GAS OR WATER RECORDS

CASING RECORD

FORMATION	CONTENT	FROM	TO	SIZE	PUT IN	PULLED OUT
				8 5/8"	171'	-0-

Describe in detail the manner in which the well was plugged, indicating where the mud fluid
was placed and the method or methods used in introducing it into the hold. If cement or other
plugs were used, state the character of same and depth placed, from _____ feet to
_____ feet for each plug set.

1st plug was set at 1080' with 100 sacks cement
2nd plug was set at 270' with 40 sacks cement
3rd plug was set at 40' with 10 sacks cement
rat hole was plugged with 10 sacks
mouse hole was plugged with 10 sacks

(If additional description is necessary, use BACK of this sheet)

Name of Plugging Contractor Dreiling Oil, Inc., Victoria, KS 67671

STATE OF Kansas COUNTY OF Rooks, ss.

I, Kenneth O Brown d/b/a Kenny Brown Enterprises (employee of owner) or (owner or operator
of the above-described well, being first duly sworn on oath, says: That I have knowledge of
the facts, statements, and matters herein contained and the log of the above-described well
as filed and that the same are true and correct. So help me God.

(Signature) Kenneth O Brown
Drawer 340 Plainville, Kansas 67663
(Address)

SUBSCRIBED AND SWORN TO before me this 24 day of September, 1982

Cindy M. Eichman
Notary Public.

My commission expires 8/18/82

RECEIVED
STATE CORPORATION COMMISSION

SEP 27 1982

CONSERVATION DIVISION
Wichita, Kansas

NOTARY PUBLIC - State of Kansas
1
CINDY M. EICHMAN
My Appt. Exp. 8/18/82