

CARD MUST BE TYPED

State of Kansas
NOTICE OF INTENTION TO DRILL
(see rules on reverse side)

CARD MUST BE SIGNED

Starting Date: 11 / 15 / 84
month day year 4:00

API Number 15- 163-01,013-00-01
NW NW SW Sec 30 Twp 6S S, Rge 20W East
(location) West

OPERATOR: License # 5140
Name Frontier Oil Company
Address 1720 Kansas State Bk Bldg
City/State/Zip Wichita, Kansas 67202
Contact Person George A. Angle
Phone 316-263-1201

2310 Ft North from Southeast Corner of Section
4950 Ft West from Southeast Corner of Section
(Note: Locate well on Section Plat on reverse side)

CONTRACTOR: License # 5302
Name Red Tiger Drilling Co.
City/State Wichita, KS 67202

Nearest lease or unit boundary line 330 feet.
County Rooks
Lease Name Voss Well# 1

Well Drilled For: Well Class: Type Equipment:
 Oil Swd Infield Mud Rotary
 Gas Inj Pool Ext. Air Rotary
 OWWO Expl Wildcat Cable

Domestic well within 330 feet: yes no
Municipal well within one mile: yes no

Depth to Bottom of fresh water 30' feet
Lowest usable water formation alluvium Dakota
Depth to Bottom of usable water 30' / 100' feet
Surface pipe by Alternate: 1 of 8
Surface pipe to be set 171' feet
Conductor pipe if any required N/A feet
Ground surface elevation 2265 KB feet MSL
This Authorization Expires 5-13-85
Approved By 11-13-84 *George A. Angle*

If OWWO: old well info as follows:
Operator Brooks Pierce Drlg. Et Al
Well Name #1 Nichol
Comp Date 12-22-50 Old Total Depth 3840
Projected Total Depth 3840 feet
Projected Formation at TD Arbuckle
Expected Producing Formations Arbuckle

I certify that we will comply with K.S.A. 55-101, et seq., plus event drilling hole to K.C.C. specifications.

Date 11/13/84 Signature of Operator or Agent

George A. Angle

Title OWNER
MHC/UDHE 11/13/84

**Must be filed with the K.C.C. five (5) days prior to commencing well
This card void if drilling not started within six (6) months of date received by K.C.C.**


RECEIVED
STATE CORPORATION COMMISSION

A Regular Section of band
1 Mile - 5,280 Ft.

11-17-84

Important procedures to follow :

1. Notify District office before setting surface casing.
2. Set surface casing by circulating cement to the top.
3. File completion forms ACO-1 with K.C.C. within 90 days of well completion, following instructions on ACO-1, side 1, and including copies of wireline logs.
4. Notify District office 48 hours prior to old well workover or re-entry.
5. Prior to plugging, prepare a plugging plan, then obtain agreement from the appropriate district office for an approved plugging plan.
6. Submit plugging report (CP-4) to K.C.C. after plugging is completed.
7. Obtain an approved injection docket number before disposing of salt water.
8. Notify K.C.C. within 10 days when injection commences or terminates.
9. If an alternate 2 completion, cement in the production pipe from below any usable water to surface within 120 days of spud date.

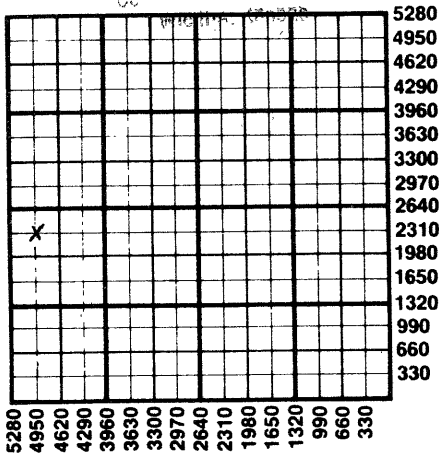

**State Corporation Commission of Kansas
Conservation Division
200 Colorado Derby Building
Wichita, Kansas 67202
(316) 263-3238**