

KANSAS CORPORATION COMMISSION
OIL & GAS CONSERVATION DIVISION
WELL PLUGGING APPLICATION
Please TYPE Form and File ONE Copy

Form CP-1
September 2003
This Form must be Typed
Form must be Signed
All blanks must be Filled

API # 15 - 035-21 055 - 00 - 00 (Identifier Number of this well). This must be listed for wells drilled since 1967; if no API # was issued, indicate original spud or completion date 10-10-1976.

Well Operator: McPherson Drilling Co. KCC License #: 5495 6/05
(Owner/Company Name) (Operator's)

Address: 15256 112th Road City: Winfield

State: Kansas Zip Code: 67156 Contact Phone: (620) 221 - 3560

Lease: Wakefield Well #: 3 Sec. 13 Twp. 31 S. R. 5 East West

NE - SW - NE Spot Location / QQQQ County: Cowley

1650 Feet (in exact footage) From North / South (from nearest outside section corner) Line of Section (Not Lease Line)

1650 Feet (in exact footage) From East / West (from nearest outside section corner) Line of Section (Not Lease Line)

Check One: Oil Well Gas Well D&A Cathodic Water Supply Well
 SWD Docket # _____ ENHR Docket # _____ Other: _____

Conductor Casing Size: N/A Set at: _____ Cemented with: _____ Sacks

Surface Casing Size: 8 5/8" Set at: 160' Cemented with: 75 Sacks

Production Casing Size: 5 1/2" Set at: 2624' Cemented with: 100 Sacks

List (ALL) Perforations and Bridgeplug Sets: Perfs 2538-44 2551-57

Elevation: 1326 (G.L. / K.B.) T.D.: 2625' PBTD: 2624' Anhydrite Depth: _____
(Stone Corral Formation)

Condition of Well: Good Poor Casing Leak Junk in Hole

Proposed Method of Plugging (attach a separate page if additional space is needed): In accordance with KCC District 2 regulations.

RECEIVED
KANSAS CORPORATION COMMISSION

FEB 28 2005

Is Well Log attached to this application as required? Yes No Is ACO-1 filed? Yes No

If not explain why? Log not available, scout card information source. CONSERVATION DIVISION
WICHITA, KS

Plugging of this Well will be done in accordance with K.S.A. 55-101 et. seq. and the Rules and Regulations of the State Corporation Commission.

List Name of Company Representative authorized to be in charge of plugging operations: Bill McPherson

Phone: (620) 229 - 0216

Address: 15256 112th Road City / State: Winfield, KS

Plugging Contractor: McPherson Drilling Co. KCC License #: 5495 6/05
(Company Name) (Contractor's)

Address: 15256 112th Road, Winfield, KS 67156 Phone: (620) 221 - 3560

Proposed Date and Hour of Plugging (if known?): March 2, 2005

Payment of the Plugging Fee (K.A.R. 82-3-118) will be guaranteed by Operator or Agent

Date: 2/28/2005 Authorized Operator / Agent: [Signature]
(Signature)

Mail to: KCC - Conservation Division, 130 S. Market - Room 2078, Wichita, Kansas 67202

CERTIFICATION OF INJECTION WELL LOCATION AND SURROUNDING ACREAGES

Partners In Crude Inc. LOCATION OF WELL:
 City of Winfield 4790 feet from SOUTH section line
 Well # 1 2970 feet from EAST section line
 County Cowley Section 13, T 31 S, R 5 East/West


PLAT

Show the following information: applicant injection well, all producing wells, abandoned wells, plugged wells, and other wells within a 1/2 mile radius, all lease boundaries, lease operators, unleased mineral rights owners, well numbers, and producing wells producing formation tops.

RECEIVED
KANSAS CORPORATION COMMISSION

FEB 28 2005

CONSERVATION DIVISION
WICHITA, KS

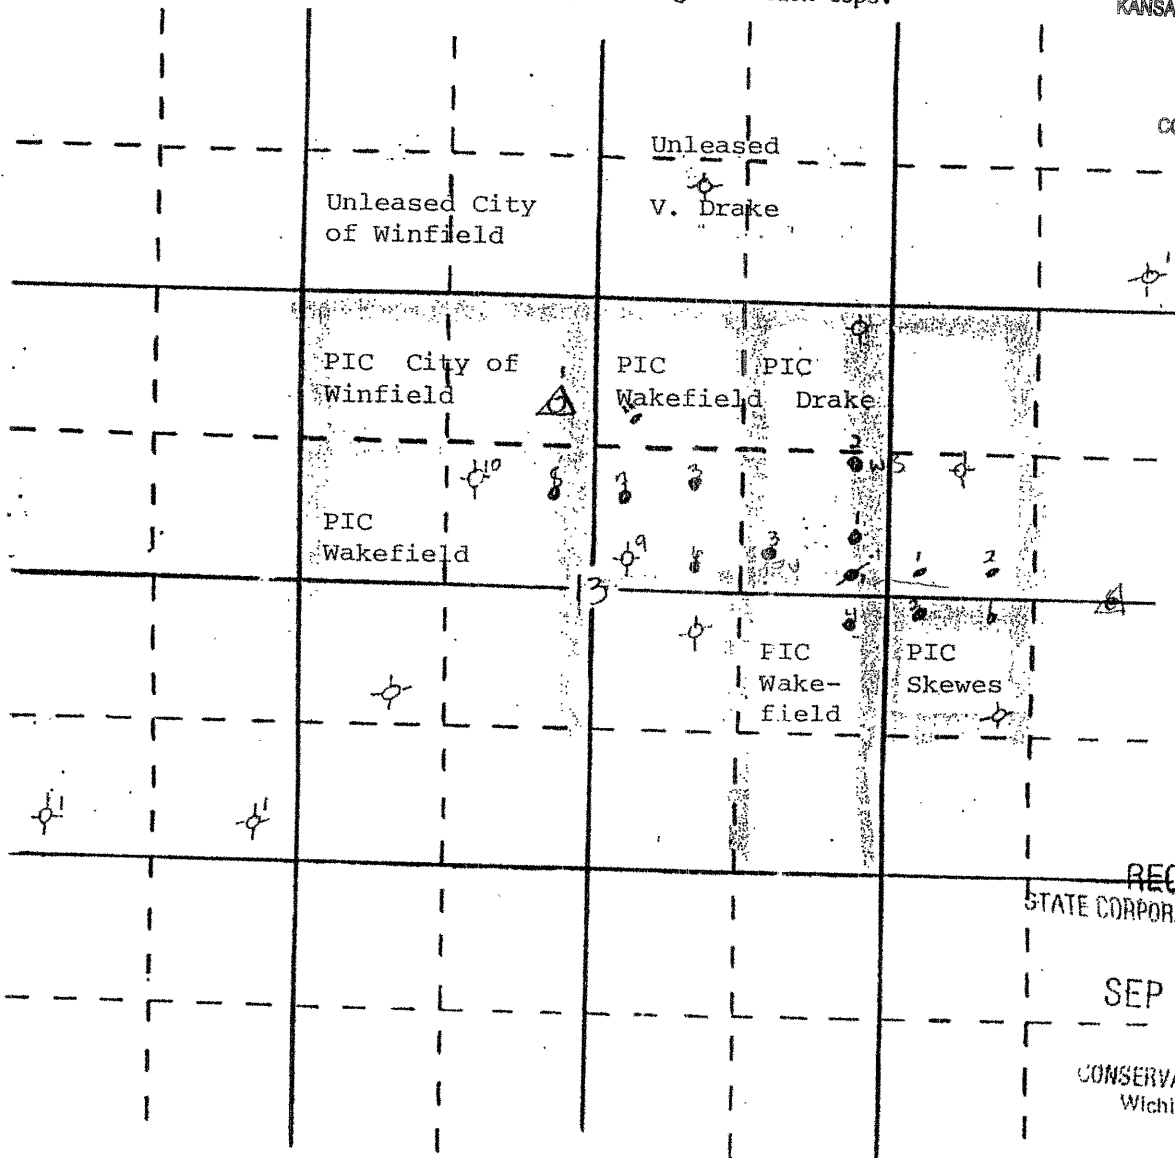

RECEIVED
STATE CORPORATION COMMISSION

SEP 9 1988

CONSERVATION DIVISION
Wichita, Kansas

- | | | | | | |
|------------------|---|----------------------|------|----------------------------|------|
| applicant well | △ | producing well | ● | plugged injection well | ⊗ |
| D & A well | ⊙ | other injection well | ▲ | temporarily abandoned well | ● TA |
| plugged producer | ⊕ | water supply well | ● WS | | |

The undersigned hereby certifies that he/she is a duly authorized agent for
 PIC Inc., and that all of the information shown
 herein is true, complete and correct.

KANSAS

CORPORATION COMMISSION

Kathleen Sebelius, Governor Brian J. Moline, Chair Robert E. Krehbiel, Commissioner Michael C. Moffet, Commissioner

NOTICE OF RECEIPT OF WELL PLUGGING APPLICATION (CP-1)

McPherson, Bill dba McPherson Drilling Co.
15256 112th Rd
Winfield, KS 67156

February 28, 2005

Re: WAKEFIELD #3
API 15-035-21055-00-00
NESWNE 13-31S-5E, 1650 FNL 1650 FEL
COWLEY COUNTY, KANSAS

Dear Operator:

This letter is to notify you that the Conservation Division is in receipt of your plugging proposal, form CP-1, for the above-captioned well.

Your CP-1 has been reviewed by the Conservation Division central office for completeness and to verify license numbers. The plugging proposal will now be forwarded to the district office listed below for review of your proposed method of plugging.

Please contact the district office for approval of your proposed plugging method at least five (5) days before plugging the well, pursuant to K.A.R. 82-3-113 (b). If a workover pit will be used during the plugging of the well it must be permitted. A CDP-1 form must be filed and approved prior to the use of the pit.

The Conservation Division's review of form CP-1, either in the central or district office, does not include an inquiry into well ownership or the filing operator's legal right to plug the well.

This notice in no way constitutes authorization to plug the above-captioned well by persons not having legal rights of ownership or interest in the well. This notice is void after ninety (90) days from the above date.

Sincerely



David P. Williams
Production Supervisor

District: #2
3450 N. Rock Road, Suite 601
Wichita, KS 67226
(316) 630-4000