

15-029-00010-00-00

STATE OF KANSAS  
STATE CORPORATION COMMISSION

WELL PLUGGING RECORD

OR


FORMATION PLUGGING RECORD

Strike out upper line  
when reporting plug-  
ging off formations.

Give All Information Completely  
Make Required Affidavit  
Mail or Deliver Report to:  
Conservation Division  
State Corporation Commission  
800 Bitting Building  
Wichita, Kansas

Cloud County. Sec. 26 Twp. 6 Rge. 2 (E) W (W)  
Location as "NE1/4NW1/4SW1/4" or footage from lines SW/4 NW/4 NW/4  
Lease Owner Stanolind Oil and Gas Company  
Lease Name Viola G. Campbell Well No. 1  
Office Address Box 591, Tulsa, Oklahoma  
Character of Well (completed as Oil, Gas or Dry Hole) Dry Hole  
Date well completed July 21, 19 50  
Application for plugging filed July 21 19 50  
Application for plugging approved July 21 19 50  
Plugging commenced July 21 19 50  
Plugging completed July 21 19 50  
Reason for abandonment of well or producing formation Dry Hole

NORTH

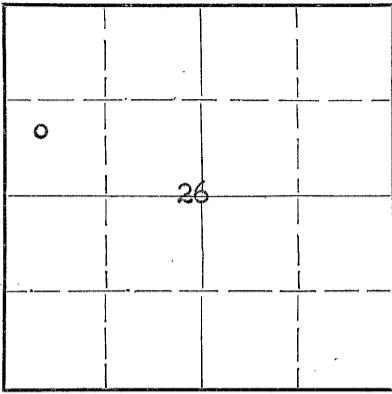

Locate well correctly on above  
Section Plat

If a producing well is abandoned, date of last production 19  
Was permission obtained from the Conservation Division or its agents before plugging was com-  
menced? Yes

Name of Conservation Agent who supervised plugging of this well Mr. Ruel Durkee  
Producing formation Depth to top Bottom Total Depth of Well 3350 Feet  
Show depth and thickness of all water, oil and gas formations.

OIL, GAS OR WATER RECORDS

CASING RECORD

Formation	Content	From	To	Size	Put In	Pulled Out
Lansing	Dry	1914		9-5/8" OD	524	0
Mississippi	Water	2470				
Hunton	Water	2749				
Viola	Slight Show Oil	3030				
Simpson	No Show	3240				
Arbuckle	Water	3317				

Describe in detail the manner in which the well was plugged, indicating where the mud fluid was placed and the method or methods used in introducing it into the hole. If cement or other plugs were used, state the character of same and depth placed, from feet to feet for each plug set.

Drilling Mud From 3350' (TD) to 275'  
Cement Plug From 275' to 220'  
Drilling Mud From 220' to 10'  
Cement Plug From 10' to 6' (Bottom of Celler)

RECEIVED

Conservation Div.

JUL 29 1950

STATE CORPORATION  
COMMISSION  
KANSAS

15-029-50

(If additional description is necessary, use BACK of this sheet)

Correspondence regarding this well should be addressed to Mr. C. B. Snyder  
Address Box 35  
Gorham, Kansas

STATE OF Kansas, COUNTY OF Russell, ss.

C. B. Snyder (employee of owner) or (owner or operator) of the above-described well,

being first duly sworn on oath, says: That I have knowledge of the facts, statements, and matters herein contained and the log of the above-described well as filed and that the same are true and correct. So help me God.

(Signature) C. B. Snyder

P.O. Box 35, Gorham, Kansas  
(Address)

SUBSCRIBED AND SWORN TO before me this 28th day of July, 19 50

Paul Barnett  
Notary Public.

My commission expires March 20, 1954

22-2625 2-48-15M



PLUGGING  
FILE SEC 26 T6 R24  
BOOK PAGE 17 LINE 34