


15-029-20002-00-00

STATE OF KANSAS
STATE CORPORATION COMMISSION

Form CP-4

Give All Information Completely
Make Required Affidavit
Mail or Deliver Report to:
Conservation Division
State Corporation Commission
212 No. Market
Wichita, Kansas 67202

WELL PLUGGING RECORD

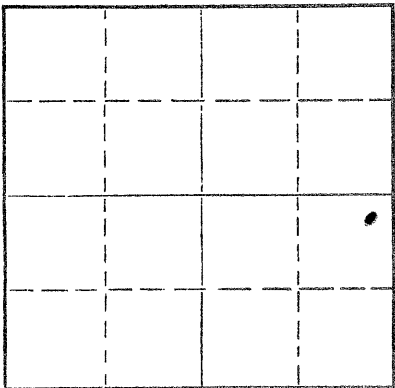

Locate well correctly on above
Section Plat

Cloud _____ County. Sec. 17 Twp. 6S Rge. (E) 1 (W) _____
Location as "NE/CNW&SW&" or footage from lines. NE NE SE
Lease Owner Walter Duncan
Lease Name N. Barton Well No. #1
Office Address 1204-100 Park Ave. Bldg., Oklahoma City, Oklahoma
Character of Well (completed as Oil, Gas or Dry Hole) Dry Hole
Date well completed 6-14-70 1970
Application for plugging filed 6-17 1970
Application for plugging approved _____ 19____
Plugging commenced 6-13 1970
Plugging completed 6-14 1970
Reason for abandonment of well or producing formation Lansing Zone structurally
low

If a producing well is abandoned, date of last production _____ 19____
Was permission obtained from the Conservation Division or its agents before plugging was commenced? Yes (Verbal permission was granted)

Name of Conservation Agent who supervised plugging of this well Hugh Scott
Producing formation None Depth to top _____ Bottom _____ Total Depth of Well 2660 Feet
Show depth and thickness of all water, oil and gas formations.

OIL, GAS OR WATER RECORDS

CASING RECORD

FORMATION	CONTENT	FROM	TO	SIZE	PUT IN	PULLED OUT
Dakota	Water	125'	180'	8-5/8"	286'	0

Describe in detail the manner in which the well was plugged, indicating where the mud fluid was placed and the method or methods used in introducing it into the hole. If cement or other plugs were used, state the character of same and depth placed, from 275' feet to 40' feet for each plug set.

Set cement plug with 25 sx at 275'. Set cement plug with 10 sx at 40'.

RECEIVED
STATE CORPORATION COMMISSION
JUN 22 1970
CONSERVATION DIVISION
Wichita, Kansas

10-22-70

(If additional description is necessary, use BACK of this sheet)

Name of Plugging Contractor Roscoe Mendenhall
Address P. O. Box 1084 Emporia, Kansas

STATE OF Oklahoma, COUNTY OF Oklahoma, ss.
J. F. Carter, Jr. (employee of owner) or (owner or operator) of the above-described well, being first duly sworn on oath, says: That I have knowledge of the facts, statements, and matters herein contained and the log of the above-described well as filed and that the same are true and correct. So help me God.

(Signature) [Signature]

1204-100 Park Avenue Building
(Address)

SUBSCRIBED AND SWORN TO before me this 19th day of June, 1970

My commission expires August 8, 1973

[Signature]
Notary Public.