

15-123-00009-00-00

STATE OF KANSAS
STATE CORPORATION COMMISSION

Give All Information Completely
Make Required Affidavit
Mail or Deliver Report to:
Conservation Division
State Corporation Commission
800 Bitting Building
Wichita, Kansas

WELL PLUGGING RECORD

Mitchell County, Sec. 34 Twp. 6S Rge. 9W (E) (W)

Location as "NE/CNW $\frac{1}{4}$ /SW $\frac{1}{4}$ " or footage from lines SW SW NE

Lease Owner A. D. Allison et al

Lease Name Reinhardt Well No. 1

Office Address 715 Brown Building, Wichita, Kansas

Character of Well (completed as Oil, Gas or Dry Hole)

Date well completed 9-28-1950

Application for plugging filed " 19

Application for plugging approved " 19


Plugging commenced " 19

Plugging completed " 19

Reason for abandonment of well or producing formation Dry Hole

If a producing well is abandoned, date of last production 19

Was permission obtained from the Conservation Division or its agents before plugging was commenced? Yes

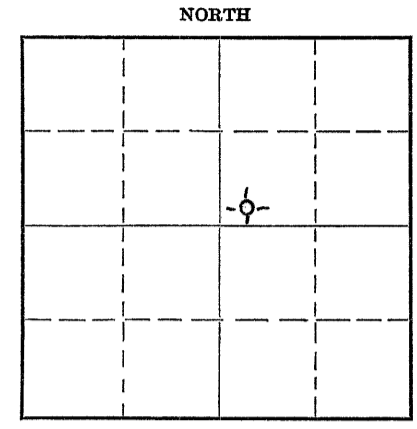

Locate well correctly on above Section Plat

Name of Conservation Agent who supervised plugging of this well C. D. Stough

Producing formation Depth to top Bottom Total Depth of Well 3955 Feet

Show depth and thickness of all water, oil and gas formations.

OIL, GAS OR WATER RECORDS

CASING RECORD

Formation	Content	From	To	Size	Put In	Pulled Out
Sand	water	210	245	8-5/8	625	none
Sand	water	358	418			

Describe in detail the manner in which the well was plugged, indicating where the mud fluid was placed and the method or methods used in introducing it into the hole. If cement or other plugs were used, state the character of same and depth placed, from feet to feet for each plug set.

Set bottom plug at 250'. Mixed and poured 15 sx cement through drill pipe. Set plug at 20'. Mixed and poured 10 sx cement.

RECEIVED
STATE CORPORATION COMMISSION
OCT 4 - 1950
CONSERVATION DIVISION
Wichita, Kansas

10-4-50

(If additional description is necessary, use BACK of this sheet)

Correspondence regarding this well should be addressed to A. D. Allison & Co., Inc.,
Address 715 Brown Building, Wichita, Kansas.

STATE OF Kansas, COUNTY OF Sedgwick, ss.
J. A. Allison (employee of owner) or (owner or operator) of the above-described well,

being first duly sworn on oath, says: That I have knowledge of the facts, statements, and matters herein contained and the log of the above-described well as filed and that the same are true and correct. So help me God.

(Signature) J. A. Allison
715 Brown Building, Wichita, Kansas
(Address)

SUBSCRIBED AND SWORN to before me this 2nd day of October, 1950.

Notary Public.

My commission expires 7-22-53

23-3273-s 4-50-10M

PLUGGING
FILE SEC 34 T 6 R 9
BOOK PAGE 31 LINE 37