

15-123-19001-00-01


STATE OF KANSAS  
STATE CORPORATION COMMISSION

Give All Information Completely  
Make Required Affidavit  
Mail or Deliver Report to:  
Conservation Division  
State Corporation Commission  
212 North Market, Insurance Bldg.  
Wichita, Kansas

WELL PLUGGING RECORD

Mitchell County. Sec. 23 Twp. 6 Rge. 9 (E) (W)  
Location as "NE/CNW/SW" or footage from lines NW C SW NW  
Lease Owner Wilcox Oil Company  
Lease Name Gish Well No. 1  
Office Address Box 1440 Tulsa 1, Oklahoma  
Character of Well (completed as Oil, Gas or Dry Hole) Dry Hole  
Date well completed Drilled In 1924 & 1925 19  
Application for plugging filed June 1925  
Application for plugging approved \_\_\_\_\_ 19\_\_\_\_  
Plugging commenced Re- Plug Started July 3, 1960  
Plugging completed " " " July 9, 1960  
Reason for abandonment of well or producing formation \_\_\_\_\_

NORTH

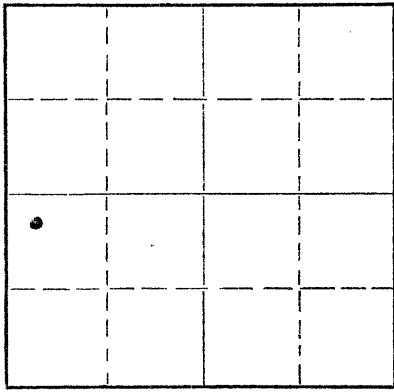

Locate well correctly on above  
Section Plat

If a producing well is abandoned, date of last production \_\_\_\_\_ 19\_\_\_\_  
Was permission obtained from the Conservation Division or its agents before plugging was commenced? Yes

Name of Conservation Agent who supervised plugging of this well Mr. Gilbert J. Toman  
Producing formation \_\_\_\_\_ Depth to top \_\_\_\_\_ Bottom \_\_\_\_\_ Total Depth of Well 3634 Feet  
Show depth and thickness of all water, oil and gas formations.

OIL, GAS OR WATER RECORDS

CASING RECORD

FORMATION	CONTENT	FROM	TO	SIZE	PUT IN	PULLED OUT

Describe in detail the manner in which the well was plugged, indicating where the mud fluid was placed and the method or methods used in introducing it into the hole. If cement or other plugs were used, state the character of same and depth placed, from ( 0 ) feet to 285 feet for each plug set.

The well was plugged with 50 sax salt jel circulated down 15' casing, followed with 460 sax reg cement circulated.

RECEIVED  
STATE CORPORATION COMMISSION

JUL 22 1960

CONSERVATION DIVISION  
Wichita, Kansas

7-22-60

(If additional description is necessary, use BACK of this sheet)

Name of Plugging Contractor Halliburton Cementing Co/  
Address \_\_\_\_\_

STATE OF Kansas, COUNTY OF Kingman, ss. \_\_\_\_\_  
(employee of owner) or (owner or operator) of the above-described well, being first duly sworn on oath, says: That I have knowledge of the facts, statements, and matters herein contained and the log of the above-described well as filed and that the same are true and correct. So help me God.

(Signature) E. C. Stephens

(Address) \_\_\_\_\_

SUBSCRIBED AND SWORN TO before me this 21 day of July, 1960

My commission expires 24 Sept 1960  
James Warner  
Notary Public.

