


15-123-00002-00-00

STATE OF KANSAS  
STATE CORPORATION COMMISSION

WELL PLUGGING RECORD

Give All Information Completely  
Make Required Affidavit  
Mail or Deliver Report to:  
Conservation Division  
State Corporation Commission  
800 Bitting Building  
Wichita, Kansas

NORTH

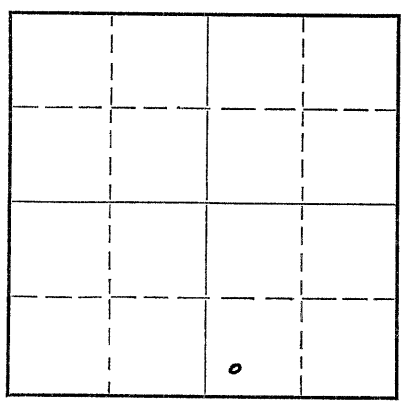

Locate well correctly on above  
Section Plat

Mitchell County. Sec. 15 Twp. 6 S. Rge. 9W (E) (W)  
Location as "NE/CNW $\frac{1}{4}$ SW $\frac{1}{4}$ " or footage from lines SW SW SE  
Lease Owner Natl. Assoc. Petr. Co.  
Lease Name Carl Thiessen Well No. 1  
Office Address 5th Floor Ritz Bldg. - Tulsa, Oklahoma  
Character of Well (completed as Oil, Gas or Dry Hole) Dry Hole  
Date well completed February 17, 1953  
Application for plugging filed February 17, 1953  
Application for plugging approved February 17, 1953  
Plugging commenced February 17, 1953  
Plugging completed February 17, 1953  
Reason for abandonment of well or producing formation Dry Hole

If a producing well is abandoned, date of last production 19...  
Was permission obtained from the Conservation Division or its agents before plugging was commenced? Yes

Name of Conservation Agent who supervised plugging of this well Ruel S. Durkee  
Producing formation Depth to top Bottom Total Depth of Well 3960 Feet  
Show depth and thickness of all water, oil and gas formations.

OIL, GAS OR WATER RECORDS

CASING RECORD

Formation	Content	From	To	Size	Put In	Pulled Out
Lans-Kansas City	Water	2504	2836	10-3/4"	157'	None
Mississippian	Water	3189	3341	8-5/8"	936'	None
Kinderhook	Water	3341	3353			
Hunton	Water	3353	3534			
Viola	Water	3543	3841			
Simpson	Water	3841	3909			
Arbuckle	Water	3909	3960			

Describe in detail the manner in which the well was plugged, indicating where the mud fluid was placed and the method or methods used in introducing it into the hole. If cement or other plugs were used, state the character of same and depth placed, from feet to feet for each plug set.

Circulated on bottom for 2 hours; came out of hole half way; circulated 30 minutes.  
Set a permanent bridge at 220 feet; spotted 25 sacks of cement;  
Set a bridge plug 10 feet from surface; spotted 5 sx cement.

(If additional description is necessary, use BACK of this sheet)

Correspondence regarding this well should be addressed to National Associated Petroleum Company  
Address 5th Floor Ritz Bldg. - Tulsa, Oklahoma

STATE OF Oklahoma, COUNTY OF Tulsa, ss.  
E. D. Ruse, (employee of owner) or (owner/operator) of the above-described well,  
being first duly sworn on oath, says: That I have knowledge of the facts, statements, and matters herein contained and the log of the above-described well as filed and that the same are true and correct. So help me God.  
(Signature) E. D. Ruse  
5th Floor Ritz Bldg. - Tulsa, Oklahoma (Address)

SUBSCRIBED AND SWORN to before me this 18th day of February, 1953.

My commission expires February 19, 1953

Mafine M. Davis  
Notary Public.

23-3278-s 4-50-10M

PLUGGING  
FILE SEC 15 T 6 R 9W  
BOOK PAGE 80 LINE 5

STATE CORPORATION COMMISSION ON

FEB 19 1953

CONSERVATION DIVISION  
Wichita, Kansas

2-19-53