

15-123-19000-00
WELL PLUGGING RECORD


STATE OF KANSAS
STATE CORPORATION COMMISSION

Give All Information Completely
Make Required Affidavit
Mail or Deliver Report to:
Conservation Division
State Corporation Commission
800 Biting Building
Wichita, Kansas

OR
FORMATION PLUGGING RECORD

Strike out upper line
when reporting plugging
off formations.

NORTH

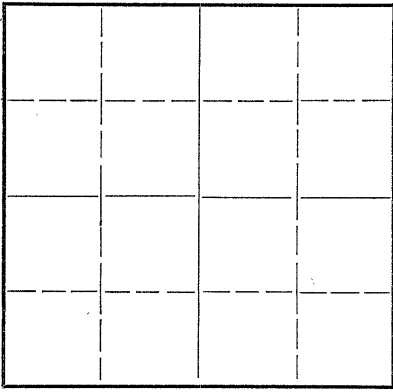

Locate well correctly on above
Section Plat

Mitchell County. Sec. 1 Twp. 6S Rge 7 (E) (W)
Location as "NE 1/4 NW 1/4 SW 1/4" or footage from lines C NW NE
Lease Owner Chas. M. Coats et al
Lease Name Black Well No. 1
Office Address 917 Union National Bank Bldg. Wichita, Kansas
Character of Well (completed as Oil, Gas or Dry Hole) Dry
Date well completed February 1 1943
Application for plugging filed February 2 19 43
Application for plugging approved February 2 19 43
Plugging commenced February 2 19 43
Plugging completed February 2 19 43
Reason for abandonment of well or producing formation Dry Hole

If a producing well is abandoned, date of last production 19
Was permission obtained from the Conservation Division or its agents before plugging was commenced? Yes

Name of Conservation Agent who supervised plugging of this well Ruel Durkee
Producing formation Depth to top Bottom Total Depth of Well 3952 Feet
Show depth and thickness of all water, oil and gas formations.


OIL, GAS OR WATER RECORDS

CASING RECORD

Formation	Content	From	To	Size	Put In	Pulled Out
Surface		0	90	12 1/2"	90	Left in

Describe in detail the manner in which the well was plugged, indicating where the mud fluid was placed and the method or methods used in introducing it into the hold. If cement or other plugs were used, state the character of same and depth placed, from feet to feet for each plug set.

25 sacks cement @ 300'
10 sacks cement at surface
Balance of hole filled with rotary mud

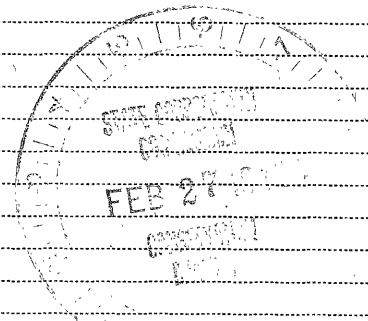

(If additional description is necessary, use BACK of this sheet)

Correspondence regarding this well should be addressed to Chas. M. Coats
Address 917 Union National Bank Bldg. Wichita, Kansas

2-27-43

1-6-7W
63-9

STATE OF Kansas, COUNTY OF Sedgwick, ss.
Chas. M. Coats (employee of owner) or (owner or operator) of the above-described well,
being first duly sworn on oath, says: That I have knowledge of the facts, statements, and matters herein contained and the log of the above-described well as filed and that the same are true and correct. So help me God.

(Signature) Chas. M. Coats

(Address)

SUBSCRIBED AND SWORN TO before me this 2nd day of February, 1943.

Sarah Staw Carpenter
Notary Public.

My commission expires January 13, 1945.

