

15-123-20001-00-01

STATE OF KANSAS
STATE CORPORATION COMMISSION

Form CP-4

WELL PLUGGING RECORD

Give All Information Completely
Make Required Affidavit
Mail or Deliver Report to:
Conservation Division
State Corporation Commission
212 No. Market
Wichita, Kansas

Mitchell

County. Sec. 31 Twp. 6S Rge. 6W ~~XX~~ (W)

Location as "NE/CNW/SW" or footage from lines. NW NW NE

Lease Owner H. C. Gillin

Lease Name Thierolf

Well No. 1

Office Address P. O. Box 914, Shawnee Mission, Kansas

Character of Well (completed as Oil, Gas or Dry Hole) Dry Hole

Date well completed August 22, 1971 19

Application for plugging filed August 21, 1971 19

Application for plugging approved August 21, 1971 19


Plugging commenced 7:00 AM, August 22, 1971 19

Plugging completed 9:00 AM, August 22, 1971 19

Reason for abandonment of well or producing formation Dry Hole

If a producing well is abandoned, date of last production _____ 19

Was permission obtained from the Conservation Division or its agents before plugging was commenced? Yes

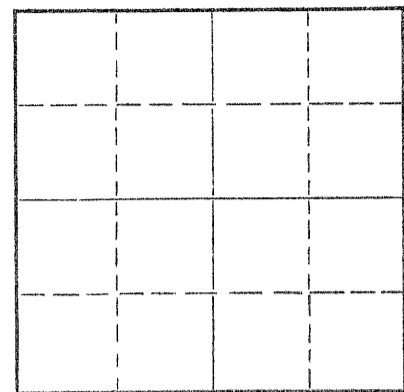

Locate well correctly on above Section Plat

Name of Conservation Agent who supervised plugging of this well Gilbert Toman

Producing formation _____ Depth to top _____ Bottom _____ Total Depth of Well 4275 Feet

Show depth and thickness of all water, oil and gas formations.

OIL, GAS OR WATER RECORDS

CASING RECORD

FORMATION	CONTENT	FROM	TO	SIZE	PUT IN	PULLED OUT
						None

Describe in detail the manner in which the well was plugged, indicating where the mud fluid was placed and the method or methods used in introducing it into the hole. If cement or other plugs were used, state the character of same and depth placed, from _____ feet to _____ feet for each plug set.

Filled hole with heavy mud.
Plugged with mud to 250' - 25 sacks cement
Mud to 40', plug and 1/2 sack hulls and
10 sacks cement - 2 sacks cement in rathole.

RECEIVED
STATE CORPORATION COMMISSION
AUG 24 1971
CONSERVATION DIVISION
Wichita, Kansas

8-24-71

(If additional description is necessary, use BACK of this sheet)

Name of Plugging Contractor Sterling Drilling Company

Address P. O. Box 129, Sterling, Kansas 67579

STATE OF KANSAS, COUNTY OF RICE, ss.

F. A. Wuellner

(employee of owner) or (owner or operator) of the above-described

well, being first duly sworn on oath, says: That I have knowledge of the facts, statements, and matters herein contained and the log of the above-described well as filed and that the same are true and correct. So help me God. STERLING DRILLING COMPANY

(Signature)

F. A. Wuellner, Secretary

P. O. Box 129, Sterling, Kansas 67579

(Address)

SUBSCRIBED AND SWORN TO before me this 23rd day of August, 1971.

Bernard Laudermilk
Bernard Laudermilk,

Notary Public.

My commission expires _____

BERNARD LAUDERMILK—NOTARY PUBLIC
My Commission Expires Jan. 22, 1974