

CARD MUST BE TYPED

State of Kansas

CARD MUST BE SIGNED

### NOTICE OF INTENTION TO DRILL

(see rules on reverse side)

Starting Date ..... Oct. 23, 1985  
month day year 3:45

API Number 15— 163-22,793-0000

OPERATOR: License # ..... 5430  
Name ..... Energy Three, Inc.  
Address ..... P.O. Box 1505  
City/State/Zip ..... Great Bend, KS 67530  
Contact Person ..... C. W. Dixon  
Phone ..... 316 792 5968

NW NW SE .....  
Sec. 32 Twp. 6 S, Rg. 17  East  
 West  
2310 ..... Ft. from South Line of Section  
2310 ..... Ft. from East Line of Section  
(Note: Locate well on Section Plat on reverse side)

CONTRACTOR: License # ..... 5836  
Name ..... Big Three Drilling Co., Inc.  
City/State ..... Box 52, Gorham, KS 67640

Nearest lease or unit boundary line ..... 330 ..... feet  
County ..... Rooks  
Lease Name ..... Wagner Well # ..... 1

Well Drilled For: Well Class: Type Equipment:  
 Oil  SWD  Infield  Mud Rotary  
 Gas  Inj  Pool Ext.  Air Rotary  
 OWWO  Expl  Wildcat  Cable

Ground surface elevation ..... feet MSL  
Domestic well within 330 feet:  yes  no  
Municipal well within one mile:  yes  no  
Surface pipe by Alternate: 1 X 2 1/2"  
Depth to bottom of fresh water ..... 100  
Depth to bottom of usable water ..... 700  
Surface pipe planned to be set ..... 700  
Projected Total Depth ..... 3400 ..... feet  
Formation ..... Lansing-Kansas City

If OWWO: old well info as follows:  
Operator .....  
Well Name .....  
Comp Date ..... Old Total Depth .....

I certify that well will comply with K.S.A. 55-101, et seq., plus eventually plugging hole to KCC specifications.  
\_\_\_\_\_ cementing will be done immediately upon setting production casing.  
Date ..... 10/21/85 ..... Signature of Operator or Agent Colvin Barber Title ..... as agent

For KCC Use:  
Conductor Pipe Required ..... feet; Minimum Surface Pipe Required ..... feet per Alt. 1 2  
This Authorization Expires ..... 4-21-86 ..... Approved By ..... 10-21-85


Must be filed with the K.C.C. five (5) days prior to commencing well  
 This card void if drilling not started within six (6) months of date received by K.C.C.

**Important procedures to follow:**

1. Notify District office before setting surface casing.
2. Set surface casing by circulating cement to the top.
3. File completion forms ACO-1 with K.C.C. within 90 days of well completion, following instructions on ACO-1, side 1, and including copies of wireline logs.
4. Notify District office 48 hours prior to old well workover or re-entry.
5. Prior to filing Intent, prepare a proposed plugging plan in case well is D & A, then obtain approval of plan when calling district office prior to setting surface pipe.
6. Submit plugging report (CP-4) to K.C.C. after plugging is completed.
7. Obtain an approved injection docket number before disposing of salt water.
8. Notify K.C.C. within 10 days when injection commences or terminates.
9. If an alternate 2 completion, cement in the production pipe from below any usable water to surface within 120 days of spud date.

**A Regular Section of Land**  
 1 Mile = 5,280 Ft.<sup>2</sup>

RECEIVED  
 STATE CORPORATION COMMISSION  
 10-21-85  
 OCT 21 1985

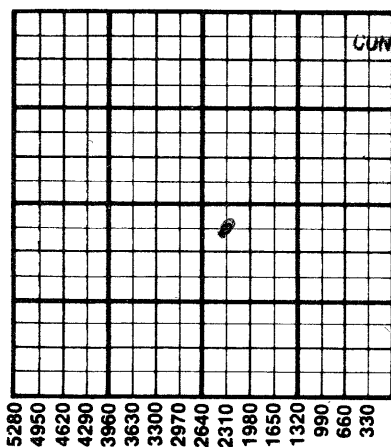

CONSERVATION DIVISION  
 Wichita, Kansas

State Corporation Commission of Kansas  
 Conservation Division  
 200 Colorado Derby Building  
 Wichita, Kansas 67202  
 (316) 263-3238