

CARD MUST BE TYPED

State of Kansas

CARD MUST BE SIGNED

NOTICE OF INTENTION TO DRILL

(see rules on reverse side)

Expected Spud Date. MAY 24, 1988
month day year

API Number 15—163-22,999-00-00 1 East

OPERATOR: License # 5537

SE SW NW Sec. 19 Twp. 6 S. Rg. 19 X West

Name KENNY BROWN ENTERPRISES

2970 Ft. from South Line of Section

Address DRAWER 340

4290 Ft. from East Line of Section

City/State/Zip PLAINVILLE, KS 67663

Contact Person KENNY BROWN

Phone 913-434-7236

(Note: Locate well on Section Plat on reverse side)

Nearest lease or unit boundary line 600 feet

County ROOKS

CONTRACTOR: License # 9087

Lease Name BUSS Well # 1

Name R & C DRILLING

Ground surface elevation 2132 feet MSL

City/State P. O. BOX 296 HAYS, KS 67601

Domestic well within 330 feet: yes X no

Well Drilled For: Well Class: Type Equipment:

Municipal well within one mile: yes X no

XOil Storage XInfield XMud Rotary

Depth to bottom of fresh water. 70

Gas Inj Pool Ext. Air Rotary

Depth to bottom of usable water 900

OWWO Expl Wildcat Cable

Surface pipe by Alternate: 1 X

If OWWO: old well info as follows:

Surface pipe planned to be set 200

Operator

Conductor pipe required N/A

Well Name

Projected Total Depth 3650 feet

Comp Date..... Old Total Depth.....

Formation ARBUCKLE

I certify that well will comply with K.S.A. 55-101, et seq., plus eventually plugging hole to KCC specifications.

Date 5-19-88 Signature of Operator or Agent

Title AGENT

For KCC Use:

Conductor Pipe Required feet; Minimum Surface Pipe Required 200 feet per Alt. X 2

This Authorization Expires 11-19-88 Approved By RCH 5-19-88


EFFECTIVE DATE: 5-24-88

Must be filed with the K.C.C. five (5) days prior to commencing well
 This card void if drilling not started within six (6) months of date received by K.C.C.

Important procedures to follow:

1. Notify District office before setting surface casing.
2. Set surface casing by circulating cement to the top.
3. File completion forms ACO-1 with K.C.C. within 120 days of well spud date, following instructions on ACO-1, side 1, and including copies of wireline logs.
4. Notify District office 48 hours prior to old well workover or re-entry.
5. Prior to filing Intent, prepare a proposed plugging plan in case well is D & A, then obtain approval of plan when calling district office prior to setting surface pipe.
6. Submit plugging report (CP-4) to K.C.C. after plugging is completed.
7. Obtain an approved injection docket number before disposing of salt water.
8. Notify K.C.C. within 10 days when injection commences or terminates.

**A Regular Section of Land
 1 Mile = 5,280 Ft.**

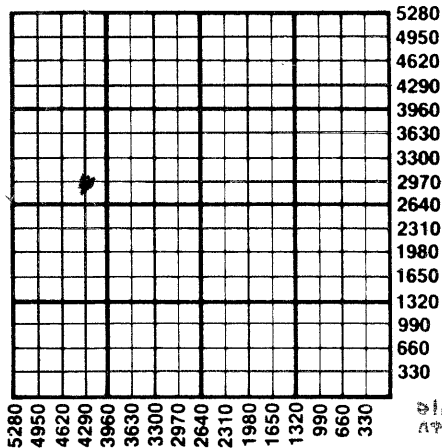

RECEIVED
 STATE CORPORATION COMMISSION
 ATATAP CORPORAT

MAY 19 1988
 05-19-1988
 CONSERVATION DIVISION
 Wichita, Kansas

9. If an alternate 2 completion, cement in the production pipe from below any usable water to surface within 120 days of spud date.

State Corporation Commission of Kansas
 Conservation Division
 200 Colorado Derby Building
 Wichita, Kansas 67202-1212
 (316) 263-3238