

CARD MUST BE TYPED

State of Kansas

CARD MUST BE SIGNED

NOTICE OF INTENTION TO DRILL

(see rules on reverse side)

Starting Date October 21 1985
month day year
6926

API Number 15— 163-12,792-00-00

OPERATOR: License #
Name Advantage Resources, Inc.
Address 1775 Sherman St., Ste 1980
City/State/Zip Denver, CO 80203
Contact Person John Zimmerman
Phone 303.831.1912

NW NW SE 19 — East
..... Sec. Twp. 6 S, Rg. X West
..... 2310 Ft. from South Line of Section
..... 2310 Ft. from East Line of Section
(Note: Locate well on Section Plat on reverse side)

CONTRACTOR: License # .. 6033
Name Murfin Drilling Co.
City/State Wichita, Ks.

Nearest lease or unit boundary line 330 feet
County Rocks
Lease Name .. Carpenter Well # .. 10B-19 ...
Ground surface elevation 2125 feet MSL
Domestic well within 330 feet: yes X no
Municipal well within one mile: yes X no
Surface pipe by Alternate: 1 2 X
Depth to bottom of fresh water 150
Depth to bottom of usable water 1100
Surface pipe planned to be set 250
Projected Total Depth 3670 feet
Formation Arbuckle

Well Drilled For: Well Class: Type Equipment:
X Oil SWD Infield X Mud Rotary
Gas Inj Pool Ext. Air Rotary
OWWO Expl X Wildcat Cable

If OWWO: old well info as follows:
Operator
Well Name
Comp Date Old Total Depth

I certify that well will comply with K.S.A. 55-101, et seq., plus eventually plugging hole to KCC specifications.

XX cementing will be done immediately upon setting production casing.

Date ... 10/21/85 ... Signature of Operator or Agent *Edmund Barboam* Title as agent

For KCC Use:

Conductor Pipe Required feet; Minimum Surface Pipe Required feet per Alt. 1 2

This Authorization Expires 4-21-86 Approved By 10-21-85 *R*

PCO/KCC

Must be filed with the K.C.C. five (5) days prior to commencing well
 This card void if drilling not started within six (6) months of date received by K.C.C.

RECEIVED
 STATE CORPORATION COMMISSION
 10-21-1985
 OCT 21 1985

Important procedures to follow:

A Regular Section of Land
1 Mile = 5,280 Ft.

CONSERVATION DIVISION
 Wichita, Kansas

1. Notify District office before setting surface casing.
 2. Set surface casing by circulating cement to the top.

3. File completion forms ACO-1 with K.C.C. within 90 days of well completion, following instructions on ACO-1, side 1, and including copies of wireline logs.

4. Notify District office 48 hours prior to old well workover or re-entry.


5. Prior to filing Intent, prepare a proposed plugging plan in case well is D & A, then obtain approval of plan when calling district office prior to setting surface pipe.

6. Submit plugging report (CP-4) to K.C.C. after plugging is completed.

7. Obtain an approved injection docket number before disposing of salt water.

8. Notify K.C.C. within 10 days when injection commences or terminates.

9. If an alternate 2 completion, cement in the production pipe from below any usable water to surface within 120 days of spud date.

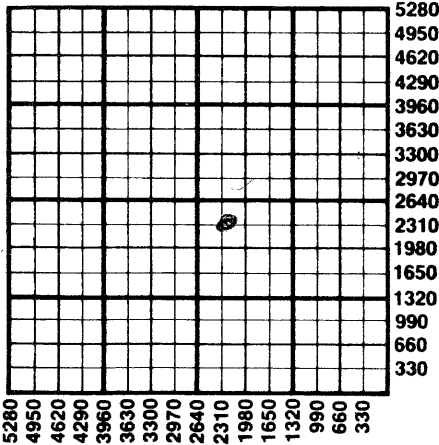

State Corporation Commission of Kansas
 Conservation Division
 200 Colorado Derby Building
 Wichita, Kansas 67202
 (316) 263-3238