


STATE OF KANSAS  
STATE CORPORATION COMMISSION

WELL PLUGGING RECORD

Give All Information Completely  
Make Required Affidavit  
Mail or Deliver Report to  
Conservation Division  
State Corporation Comm.  
245 North Water  
Wichita, KS 67202

Graham County. Sec. 1 Twp. 6S Rge. 21W E/W  
Location as "NE/CNW $\frac{1}{4}$ SW $\frac{1}{4}$ " or footage from lines  
NW/4 NW/4 SE/4

Lease Owner Petroleum Management, Inc.  
Lease Name Hoylman Well No. 1  
Office Address 400 N. Woodlawn, Suite 201, Wichita, Ks. 67208  
Character of Well (Completed as Oil, Gas or Dry Hole)  
D & A

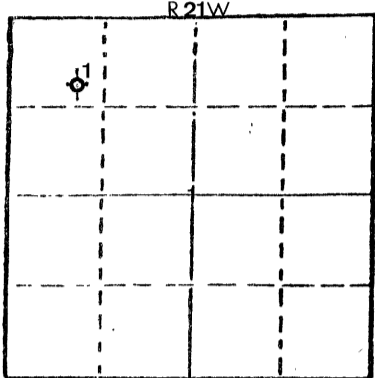

Locate well correctly on above Section Plat

Date Well completed March 27, 19 81  
Application for plugging filed March 28, 19 81  
Application for plugging approved March 28, 19 81  
Plugging commenced March 28, 19 81  
Plugging completed March 28, 19 81  
Reason for abandonment of well or producing formation  
D & A

If a producing well is abandoned, date of last production  
19

Was permission obtained from the Conservation Division or its agents before plugging was commenced? Yes

Name of Conservation Agent who supervised plugging of this well Gil Balthazor  
Producing formation \_\_\_\_\_ Depth to top \_\_\_\_\_ Bottom \_\_\_\_\_ Total Depth of Well 13,513'  
Show depth and thickness of all water, oil and gas formations.

OIL, GAS OR WATER RECORDS

CASING RECORD

FORMATION	CONTENT	FROM	TO	SIZE	PUT IN	PULLED OUT
				8 5/8"	207'	-0-

Describe in detail the manner in which the well was plugged, indicating where the mud fluid was placed and the method or methods used in introducing it into the hold. If cement or other plugs were used, state the character of same and depth placed, from \_\_\_\_\_ feet to \_\_\_\_\_ feet for each plug set.

Plug #1 @ 780' w/70 sx cement  
#2 @ 240' w/20 sx cement  
Bridge @ 40' w/10 sx cement  
5 sx cement in rathole  
50-50 Pozmix, 6% Gel

RECEIVED  
STATE CORPORATION COMMISSION

APR 7 1981

CONSERVATION DIVISION  
Wichita, Kansas

4-7-81

(If additional description is necessary, use BACK of this sheet)

Name of Plugging Contractor Red Tiger Drilling Company  
1720 KSB&T Building, Wichita, Kansas 67202

STATE OF Kansas COUNTY OF Sedgwick, ss. contractor  
Gloria Fawcett (employee of ~~owner~~)

of the above-described well, being first duly sworn on oath, says: That I have knowledge of the facts, statements, and matters herein contained and the log of the above-described well as filed and that the same are true and correct. So help me God.

(Signature) Gloria Fawcett  
1720 KSB&T Building, Wichita, Kansas 67202  
(Address)

SUBSCRIBED AND SWORN TO before me this 31st day of March, 19 81.

Joyce A. Baer  
Notary Public.

My commission expires \_\_\_\_\_

