

15-065-03331-00-00

WELL PLUGGING RECORD

STATE OF KANSAS
STATE CORPORATION COMMISSION

OR FORMATION PLUGGING RECORD

Strike out upper line
when reporting plug-
ging off formations.

Give All Information Completely
Make Required Affidavit
Mail or Deliver Report to:
Conservation Division
State Corporation Commission
800 Bittling Building
Wichita, Kansas

Graham County. Sec. 1 Twp. 6 Rge. (E) 21(W)

Location as "NE $\frac{1}{4}$ NW $\frac{1}{4}$ SW $\frac{1}{4}$ " or footage from lines C SE NE NE

Lease Owner Cetal Oil Company

Lease Name Hixenbaugh Well No. 1

Office Address 1015 Central Building, Wichita, Kansas

Character of Well (completed as Oil, Gas or Dry Hole) dry hole

Date, well completed 19

Application for plugging filed 19

Application for plugging approved 19

Plugging Commenced 3-4-41 19


Plugging Completed 3-4-41 19

Reason for abandonment of well or producing formation Dry hole

If a producing well is abandoned, date of last production 19

Was permission obtained from the Conservation Division or its agents before plugging was com-
menced? Yes

NORTH

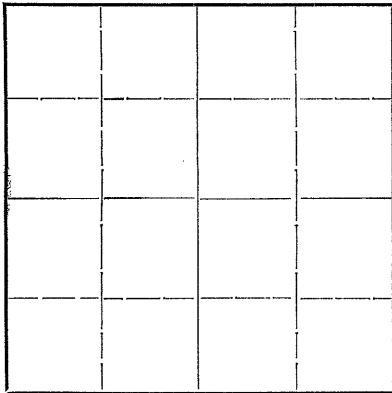

Locate well correctly on above
Section Plat

Name of Conservation Agent who supervised plugging of this well

Producing formation Depth to top Bottom Total Depth of Well 3540 Feet

Show depth and thickness of all water, oil and gas formations.

OIL, GAS OR WATER RECORDS

CASING RECORD

| Formation | Content | From | To | Size | Put In | Pulled Out |
|-----------|---------|------|----|-------------------|--------|------------|
| | | | | 5 $\frac{1}{2}$ " | 3529 | 2953 |
| | | | | 8 5/8" | 102 | -0- |
| | | | | | | |
| | | | | | | |
| | | | | | | |
| | | | | | | |
| | | | | | | |
| | | | | | | |

Describe in detail the manner in which the well was plugged, indicating where the mud fluid was placed and the method or methods used in introducing it into the hole. If cement or other plugs were used, state the character of same and depth placed, from feet to feet for each plug set.

Cemented 3540 to 3512 with dump bailer - 4 sacks


Filled with mud 3512 to 250

Bridged solid with rock 250-245

Cemented 245 to 220 - 4 sacks

Filled with mud 220' to 10' of cellar base

Cemented 10' to cellar base - ran cement cap (5 sacks)

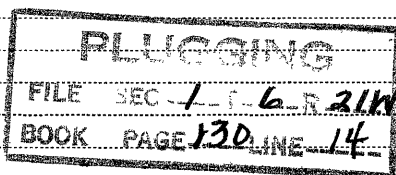

3-26-41

(If additional description is necessary, use BACK of this sheet)

Correspondence regarding this well should be addressed to Cetal Oil Company

Address 1015 Central Building, Wichita, Kansas

STATE OF Kansas, COUNTY OF Sedgwick, ss.

I, W. A. Grant, (employee of owner) or (owner or operator) of the above-described well, being first duly sworn on oath, says: That I have knowledge of the facts, statements, and matters herein contained and the log of the above-described well as filed and that the same are true and correct. So help me God.

(Signature)

1015 Central Building, Wichita, Kansas
(Address)

SUBSCRIBED AND SWORN to before me this 24th day of March, 19 41

My commission expires April 7, 1943.



Margaret O. Reilly
Notary Public.