


15-163-20940-00

STATE OF KANSAS
STATE CORPORATION COMMISSION
CONSERVATION DIVISION
P. O. BOX 17027
WICHITA, KANSAS 67217

FORM CP-4

WELL PLUGGING RECORD

Rocks _____ County. Sec. 20 Twp. 6S Rge. _____ (E) 19 (W)
Location as "NE/CNW/SW" or footage from lines NE SE SE
Lease Owner Zenith Drilling Corporation, Inc.
Lease Name Hamit Well No. 1
Office Address 200 West Douglas, Suite 600, Wichita, Kansas 67202
Character of Well (completed as Oil, Gas or Dry Hole) Dry Hole
Date well completed _____ Sept. 10 1974
Application for plugging filed _____ Sept. 10 1974
Application for plugging approved _____ Sept. 10 1974
Plugging commenced _____ Sept. 10 1974
Plugging completed _____ Sept. 10 1974
Reason for abandonment of well or producing formation Dry Hole

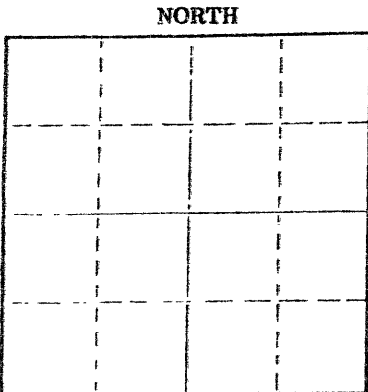

Locate well correctly on above Section Plat

If a producing well is abandoned, date of last production _____ 19____
Was permission obtained from the Conservation Division or its agents before plugging was commenced? Yes

Name of Conservation Agent who supervised plugging of this well Bill Nichols
Producing formation _____ Depth to top _____ Bottom _____ Total Depth of Well 3612 Feet
Show depth and thickness of all water, oil and gas formations.

OIL, GAS OR WATER RECORDS				CASING RECORD		
FORMATION	CONTENT	FROM	TO	SIZE	PUT IN	PULLED OUT
				8 5/8"	210'	None

Describe in detail the manner in which the well was plugged, indicating where the mud fluid was placed and the method or methods used in introducing it into the hole. If cement or other plugs were used, state the character of same and depth placed, from _____ feet to _____ feet for each plug set.

1st plug @ 975' w/110 sx
2nd plug @ 215' w/30 sx
3rd plug @ 40' w/10 sx

(If additional description is necessary, use BACK of this sheet)
Name of Plugging Contractor Halliburton
Address 410 Union Center, Wichita, Kansas

STATE OF Kansas COUNTY OF Sedgwick, ss.
James R. Daniels

(employee of owner) or ~~(owner or agent)~~ of the above-described well, being first duly sworn on oath, says: That I have knowledge of the facts, statements, and matters herein contained and the log of the above-described well as filed and that the same are true and correct. So help me God.

(Signature) [Signature]
410 Union Center, Wichita, Kansas
(Address)

SUBSCRIBED AND SWORN TO before me this 19th day of September 1974

BARBARA COLE, Notary Public
My commission expires My Commission Expires Sept. 5, 1976
[Signature] Notary Public.

