

STATE OF KANSAS  
STATE CORPORATION COMMISSION


Give All Information Completely  
Make Required Affidavit  
Mail or Deliver Report to:  
Conservation Division  
State Corporation Commission  
800 Bitting Building  
Wichita, Kansas

15-163-03934-00-00  
WELL PLUGGING RECORD

OR  
FORMATION PLUGGING RECORD

Strike out upper line  
when reporting plug-  
ging off formations.

NORTH

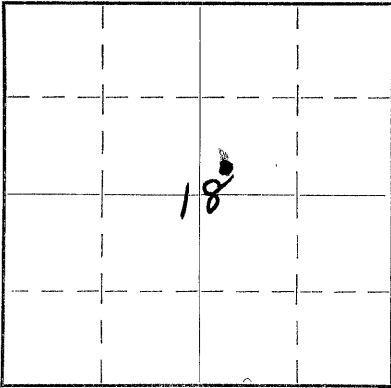

Locate well correctly on above  
Section Plat

Books \_\_\_\_\_ County. Sec. 18 Twp. 6 Rge. 1 (E) 19W

Location as "NE $\frac{1}{4}$ NW $\frac{1}{4}$ SW $\frac{1}{4}$ " or footage from lines \_\_\_\_\_  
Lease Owner Texo Trading Co. (Under supervision Big West Dr. Co)  
Lease Name A. E. Brobet Well No. 1  
Office Address 910 Philtower Bldg., Tulsa, Okla.  
Character of Well (Completed as Oil, Gas or Dry Hole) Dry Hole  
Date, well completed Dec. 17, 1937 193  
Application for plugging filed Dec. 22, 1937 193  
Application for plugging approved Dec. 22, 1937 193  
Plugging Commenced Dec. 23, 1937 193  
Plugging Completed Dec. 23, 1937 193  
Reason for abandonment of well or producing formation Dry Hole

If a producing well is abandoned, date of last production \_\_\_\_\_ 193  
Was permission obtained from the Conservation Division or its agents before plugging was commenced?  
Yes

Name of Conservation Agent who supervised plugging of this well C. T. Alexander  
Producing formation \_\_\_\_\_ Depth to top \_\_\_\_\_ Bottom \_\_\_\_\_ Total Depth of Well 3637 Feet.  
Show depth and thickness of all water, oil and gas formations.

OIL, GAS OR WATER RECORDS

CASING RECORD

| Formation | Content | From | To   | Size | Put In | Pulled Out |
|-----------|---------|------|------|------|--------|------------|
|           | Water   | 505  | 525  |      |        |            |
| Dakota    | Water   | 800  | 825  |      |        |            |
|           | "       | 830  | 844  |      |        |            |
|           | "       | 885  | 899  |      |        |            |
|           | "       | 939  | 1073 |      |        |            |
|           | "       | 1073 | 1120 |      |        |            |
|           | "       |      |      |      |        |            |

Describe in detail the manner in which the well was plugged, indicating where the mud fluid was placed and the method or methods used in introducing it into the hole. If cement or other plugs were used, state the character of same and depth placed, from \_\_\_\_\_ feet to \_\_\_\_\_ feet for each plug set.

Hole filled with heavy rotary mud from 3639 to 450 ft. and hole bridged at 450 ft. and 15 ft. cement plug set on bridge and hole filled with mud to 20 ft. and a cement plug set on top of surface pipe at bottom of cellar.

18 6 1938  
1 20  
01-19-1938

(If additional description is necessary, use BACK of this sheet)

Correspondence regarding this well should be addressed to Texon Trading Co., Tulsa, Okla.  
Address 910 Philtower Bldg.,

STATE OF Kansas, COUNTY OF  Barton, ss.  
J. C. Noles (employee of owner) ~~or (owner or operator)~~ of the above-described well,  
being first duly sworn on oath, says: That I have knowledge of the facts, statements, and matters herein contained and the log of the above-described well as filed and that the same are true and correct. So help me God.

(Signature)

Big Texo Trading Co. Dr.  
J. C. Noles  
Box 745 West Bend Texas  
(Address)

SUBSCRIBED AND SWORN TO before me this 17th day of January 19 38.

Isabel Abel  
Notary Public.


My commission expires November 25, 1939.

Well Log.

A. B. Brobst No. 1, Rocks County.  
Drilled by Helmerich & Payne for Texo Trading Co.

15-163-03934-00-00

|           |  |
|-----------|--|
| 0-238     | Sand and red shale                             |
| 238-390   | Shale  |
| 390-430   | sand   |
| 430-505   | shale  |
| 505-525   | first Dakota sand                              |
| 525-660   | sand and shale                                 |
| 660-800   | shale and shells                               |
| 800-825   | Dakota sand(soft)                              |
| 825-830   | shale  |
| 830-844   | Dakota sand(soft)                              |
| 844-885   | shale  |
| 885-899   | sand(soft)                                     |
| 899-955   | shale and sand                                 |
| 955-989   | shale  |
| 989-1073  | sand   |
| 1073-1120 | sand and shells                                |
| 1120-1215 | sand and shale                                 |
| 1215-1240 | shale  |
| 1240-1500 | sand and shale                                 |
| 1500-1571 | shale  |
| 1571-1711 | blue shale-streaks of<br>red shale             |
| 1711-1770 | anhydrite                                      |
| 1770-1969 | shale(red and blue)                            |
| 1969-2064 | shale and sand shells<br>(blue grey)           |
| 2064-2156 | sand and shale                                 |
| 2156-2314 | shale  |
| 2314-2374 | lime   |
| 2374-2530 | shale  |
| 2530-2565 | lime(brownish, sandy)                          |
| 2565-2612 | lime and shale                                 |
| 2612-2628 | red bed and shale                              |
| 2628-2632 | shale(blue and red)                            |
| 2632-2640 | lime   |
| 2640-2796 | broken lime and shale                          |
| 2796-2851 | shale  |
| 2851-3015 | shale and lime shells                          |
| 3015-3064 | lime   |
| 3064-3127 | shale and shells                               |
| 3127-3135 | lime   |
| 3135-3291 | broken lime                                    |
| 3291-3342 | hard lime                                      |
| 3342-3350 | lime(brownish)                                 |
| 3350-3597 | Kansas City lime                               |
| 3597-3614 | shale(first few feet<br>green and very sticky) |
| 3614-3639 | Granite wash.                                  |

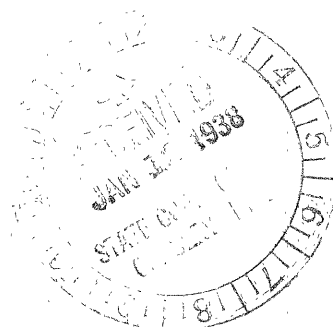

18 6 1900  
PAGE 1 LINE 20