


STATE OF KANSAS
STATE CORPORATION COMMISSION

Give All Information Completely
Make Required Affidavit
Mail or Deliver Report to:
Conservation Division
State Corporation Commission
800 Bitting Building
Wichita, Kansas

15-163-00480-00-00

WELL PLUGGING RECORD

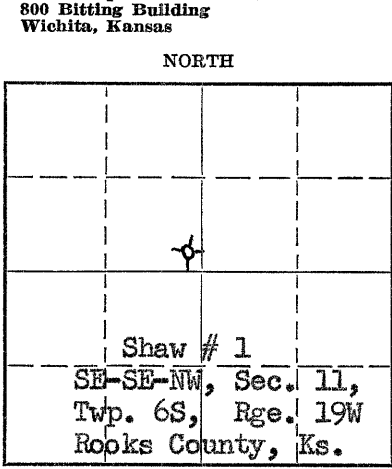

Locate well correctly on above
Section Plat

Rooks County, Sec. 11 Twp. 6S Rge. 19 (E) W (W)
Location as "NE/CNW $\frac{1}{4}$ SW $\frac{1}{4}$ " or footage from lines SE-SE-NW
Lease Owner Ed Madden
Lease Name Shaw Well No. #1
Office Address 1000 Main, Hays, Kansas.
Character of Well (completed as Oil, Gas or Dry Hole) Dryhole
Date well completed 1-3-52 19
Application for plugging filed 1-3-52 19
Application for plugging approved 1-3-52 19
Plugging commenced 1-3-52 12:00 P.M. 19
Plugging completed 1-3-52 4:00 P.M. 19
Reason for abandonment of well or producing formation Dry Hole

If a producing well is abandoned, date of last production 19
Was permission obtained from the Conservation Division or its agents before plugging was commenced? Yes Verbal

Name of Conservation Agent who supervised plugging of this well Eldon Petty
Producing formation Depth to top Bottom Total Depth of Well 3600 Feet
Show depth and thickness of all water, oil and gas formations.

OIL, GAS OR WATER RECORDS

CASING RECORD

Formation	Content	From	To	Size	Put In	Pulled Out
soil, post rock		0	170'	8 5/8"	170'	none
Base K.C.		3490	3562		dry	dry
Arbuckle		3569	3600		dry	dry

Describe in detail the manner in which the well was plugged, indicating where the mud fluid was placed and the method or methods used in introducing it into the hole. If cement or other plugs were used, state the character of same and depth placed, from _____ feet to _____ feet for each plug set.

Stirred pits well, filled hole with heavy mud to 160 Feet. Set bottom wood plug at 160'. Ran 1/2 sack hulls and 15 sks cement. Filled hole with heavy mud to 40 Ft. Set top wood plug at 40'. Ran 1/2sk Hulls and 10 sks cement filling to bottom of cellar.

01-09-1952

(If additional description is necessary, use BACK of this sheet)

Name of Plugging Contractor Strain Drilling Company
Address Box 188, Hays, Kansas.

STATE OF Kansas, COUNTY OF Ellis, ss.
T.C. Strain (employee of owner) or (owner or operator) of the above-described well,

being first duly sworn on oath, says: That I have knowledge of the facts, statements, and matters herein contained and the log of the above-described well as filed and that the same are true and correct. So help me God.

(Signature) T.C. Strain

Box 188, Hays, Kansas.
(Address)

SUBSCRIBED AND SWORN to before me this 7 day of January, 1952

My commission expires July 18, 1955 Notary Public.

23-8390-s 6-51-20M

PLUGGING
FILE SEC 11 T 6 R 19W
BOOK PAGE 136 LINE 21