


STATE OF KANSAS
STATE CORPORATION COMMISSION

Give All Information Completely
Make Required Affidavit
Mail or Deliver Report to:
Conservation Division
State Corporation Commission
800 Bittling Building
Wichita, Kansas

15-1163-00649-00-00
WELL PLUGGING RECORD

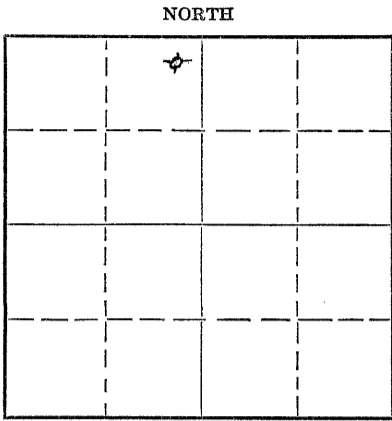

Locate well correctly on above
Section Plat

Rooks County. Sec. 10 Twp. 6 Rge. (E) 19 (W)
Location as "NE/CNW $\frac{1}{4}$ SW $\frac{1}{4}$ " or footage from lines NE NE NW
Lease Owner Long Brothers
Lease Name Shaw Well No. 1
Office Address 4638 J.C. Nichols Pkwy., Kansas City, Missouri
Character of Well (completed as Oil, Gas or Dry Hole) Dry Hole
Date well completed 4-18-53 19
Application for plugging filed 4-18-53 19
Application for plugging approved 4-18-53 19
Plugging commenced 4-18-53 19
Plugging completed 4-18-53 19
Reason for abandonment of well or producing formation Dry Hole

If a producing well is abandoned, date of last production _____ 19____
Was permission obtained from the Conservation Division or its agents before plugging was commenced? Yes

Name of Conservation Agent who supervised plugging of this well Eldon Petty
Producing formation _____ Depth to top _____ Bottom _____ Total Depth of Well 3596 Feet
Show depth and thickness of all water, oil and gas formations.

OIL, GAS OR WATER RECORDS

CASING RECORD

Formation	Content	From	To	Size	Put In	Pulled Out
	surface pipe	0	200'	8-5/8"	200'	0

Describe in detail the manner in which the well was plugged, indicating where the mud fluid was placed and the method or methods used in introducing it into the hole. If cement or other plugs were used, state the character of same and depth placed, from _____ feet to _____ feet for each plug set.

Filled hole with heavy mud from total depth to 190'.
Set rock bridge at 190'. Cemented with 15 sacks on
top of bridge. Set rock bridge at 40' and cemented
with 10 sacks on top of bridge. Cement returned to
base of cellar.

RECEIVED
STATE CORPORATION COMMISSION
APR 24 1953
CONSERVATION DIVISION
Wichita, Kansas

(If additional description is necessary, use BACK of this sheet)

Name of Plugging Contractor Isern Drilling Company
Address P. O. Box 45, Ellinwood, Kansas

STATE OF KANSAS COUNTY OF BARTON SS.
M. M. Shropshire (employee of owner) or (~~owner or operator~~) of the above-described well,
being first duly sworn on oath, says: That I have knowledge of the facts, statements, and matters herein contained and the log of the above-described well as filed and that the same are true and correct. So help me God.

(Signature) M. M. Shropshire

Lyons, Kansas (Address)

SUBSCRIBED AND SWORN to before me this 21st day of April, 1953

My commission expires Feb. 10, 1955.

PLUGGING
FILE SEC 10 T 6 R 19W
BOOK PAGE 94 LINE 25

George A. Meyer
Notary Public.