

STATE OF KANSAS  
STATE CORPORATION COMMISSION


15-163-20933-00-00

WELL PLUGGING RECORD

Give All Information Completely  
Make Required Affidavit  
Mail or Deliver Report to  
Conservation Division  
State Corporation Comm.  
245 North Water  
Wichita, KS 67202

Rooks County, Sec. 6 Twp. 6s Rge. 19w E/W  
Location as "NE/CNW $\frac{1}{4}$ SW $\frac{1}{4}$ " or footage from lines  
NE-NE-NE

Lease Owner Beren Corporation  
Lease Name Florain Well No. 1  
Office Address 970 Fourth Financial Center, Wichita, Ks.  
Character of Well (Completed as Oil, Gas or Dry Hole)  
Dry hole

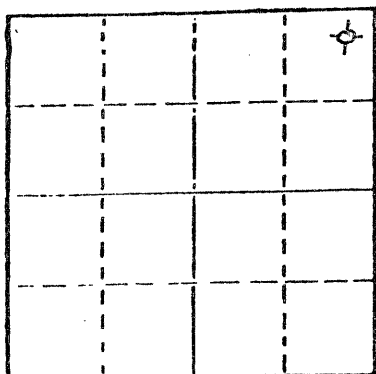

Locate well correctly on above  
Section Plat

Date Well completed July 7 1979  
Application for plugging filed July 7 1979  
Application for plugging approved July 7 1979  
Plugging commenced July 7 1979  
Plugging completed July 7 1979  
Reason for abandonment of well or producing formation  
Dry hole

If a producing well is abandoned, date of last production  
19

Was permission obtained from the Conservation Division or  
its agents before plugging was commenced? Yes

Name of Conservation Agent who supervised plugging of this well Gilbert Baltazor  
Producing formation Depth to top Bottom Total Depth of Well 3575  
Show depth and thickness of all water, oil and gas formations.


OIL, GAS OR WATER RECORDS

CASING RECORD

FORMATION	CONTENT	FROM	TO	SIZE	PUT IN	PULLED OUT
Surface		0'	261'	8 5/8"	261'	0'

Describe in detail the manner in which the well was plugged, indicating where the mud fluid was placed and the method or methods used in introducing it into the hold. If cement or other plugs were used, state the character of same and depth placed, from feet to feet for each plug set.

- 1 st. plug at 900' with 70 sacks common cement 50-50 Poz. 6% Gel.
- 2 nd. plug at 250' with 20 sacks common cement 50-50 Poz. 6% Gel.
- 3 rd. plug at 40' with 10 sacks common cement 50-50 Poz. 6% Gel.
- Three sacks in rathole.

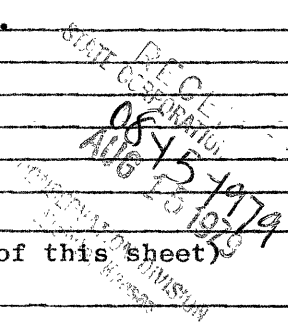

(If additional description is necessary, use BACK of this sheet)

Name of Plugging Contractor Sun Oilwell Cementing, Inc.

STATE OF Kansas COUNTY OF Graham, ss.  
Jerry M. Helberg (employee of owner) or (owner or operator)  
of the above-described well, being first duly sworn on oath, says: That I have knowledge of the facts, statements, and matters herein contained and the log of the above-described well as filed and that the same are true and correct. So help me God.

(Signature) Jerry M. Helberg  
Box 32 Morland, Kansas 67650  
(Address)

SUBSCRIBED AND SWORN TO before me this 10th day of August, 1979

James Robinson  
Notary Public.

My commission expires

Dec 4, 1979

