

15-163-0081700-00


STATE OF KANSAS  
STATE CORPORATION COMMISSION

WELL PLUGGING RECORD

Give All Information Completely  
Make Required Affidavit  
Mail or Deliver Report to:  
Conservation Division  
State Corporation Commission  
211 No. Broadway  
Wichita, Kansas

Rooks County. Sec. 4 Twp. 6 Rge. (E) 19(W)  
Location as "NE/CNW/SW" or footage from lines CNE NW  
Lease Owner Woodman & Iannitti Drilling Co.  
Lease Name Johnson Well No. 1  
Office Address 714 Union Nat'l Bldg., Wichita  
Character of Well (completed as Oil, Gas or Dry Hole) Dry Hole  
Date well completed 9-21 1961  
Application for plugging filed 9-21 1961  
Application for plugging approved 9-21 1961  
Plugging commenced 9-21 1961  
Plugging completed 9-21 1961  
Reason for abandonment of well or producing formation Dry

NORTH

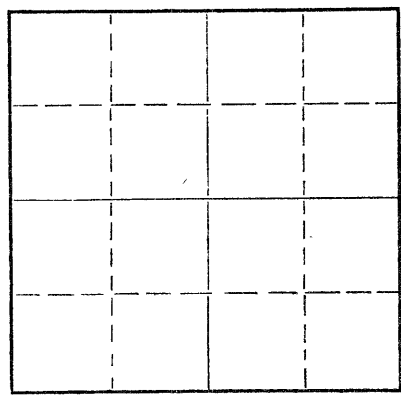

Locate well correctly on above  
Section Plat

If a producing well is abandoned, date of last production 19  
Was permission obtained from the Conservation Division or its agents before plugging was commenced? yes

Name of Conservation Agent who supervised plugging of this well Eldon Petty  
Producing formation \_\_\_\_\_ Depth to top \_\_\_\_\_ Bottom \_\_\_\_\_ Total Depth of Well 3527 Feet  
Show depth and thickness of all water, oil and gas formations.

OIL, GAS OR WATER RECORDS

CASING RECORD

FORMATION	CONTENT	FROM	TO	SIZE	PUT IN	PULLED OUT
				8 5/8"	183'	

Describe in detail the manner in which the well was plugged, indicating where the mud fluid was placed and the method or methods used in introducing it into the hole. If cement or other plugs were used, state the character of same and depth placed, from \_\_\_\_\_ feet to \_\_\_\_\_ feet for each plug set.

Bottom plug at 480' with 20 sacks cement  
Middle plug at 180' w/20 sacks cement  
Top plug at 40' w/10 sacks cement

RECEIVED  
STATE CORPORATION COMMISSION  
09-26-1961  
SEP 26 1961

CONSERVATION DIVISION  
Wichita, Kansas

(If additional description is necessary, use BACK of this sheet)  
Name of Plugging Contractor Woodman & Iannitti Drilling Co.  
Address 714 Union Nat'l Bldg., Wichita, Kansas

STATE OF Kansas, COUNTY OF Sedgwick, ss.  
K. T. Woodman (employee of owner) or (owner or operator) of the above-described well, being first duly sworn on oath, says: That I have knowledge of the facts, statements, and matters herein contained and the log of the above-described well as filed and that the same are true and correct. So help me God.

(Signature) K. T. Woodman

714 Union Nat'l Bldg.  
(Address)

SUBSCRIBED AND SWORN TO before me this 26th day of September, 1961

Frances H. Solomon  
My commission expires Oct. 10, 1963 Frances H. Solomon Notary Public.

