

15-163-30184-00-00

STATE OF KANSAS  
STATE CORPORATION COMMISSION

Form CP-4

Give All Information Completely  
Make Required Affidavit  
Mail or Deliver Report to:  
Conservation Division  
State Corporation Commission  
212 No. Market  
Wichita, Kansas

WELL PLUGGING RECORD

ROOKS County, Sec. 32 Twp. 6S Rge. (E) 17(W)

Location as "NE/CNW/SW" or footage from lines SE/4 SW/4 SE/4

Lease Owner Forrest H. Lindsay (National Assoc. Petroleum)

Lease Name Richard A. Wagner Well No. One (1)

Office Address Fifth Floor, Ritz Building

Character of Well (completed as Oil, Gas or Dry Hole) Dry Hole

Date well completed April 22 1966

Application for plugging filed April 22 Verbal 1966

Application for plugging approved April 22 " 1966


Plugging commenced April 22 1966

Plugging completed April 22 1966

Reason for abandonment of well or producing formation Dry

If a producing well is abandoned, date of last production \_\_\_\_\_ 19\_\_\_\_

Was permission obtained from the Conservation Division or its agents before plugging was commenced? Yes

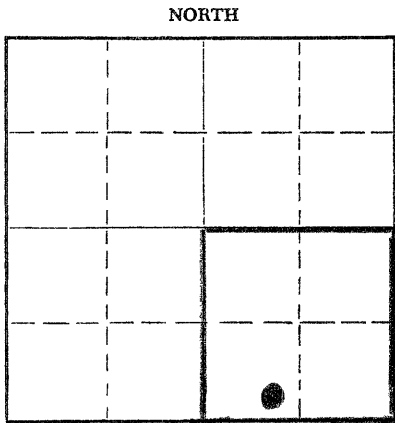

Locate well correctly on above Section Plat

Name of Conservation Agent who supervised plugging of this well \_\_\_\_\_

Producing formation \_\_\_\_\_ Depth to top \_\_\_\_\_ Bottom \_\_\_\_\_ Total Depth of Well 3235 Feet

Show depth and thickness of all water, oil and gas formations.

OIL, GAS OR WATER RECORDS

CASING RECORD

FORMATION	CONTENT	FROM	TO	SIZE	PUT IN	PULLED OUT

Describe in detail the manner in which the well was plugged, indicating where the mud fluid was placed and the method or methods used in introducing it into the hole. If cement or other plugs were used, state the character of same and depth placed, from \_\_\_\_\_ feet to \_\_\_\_\_ feet for each plug set.

Filled with drilling mud to 540'  
30 sack cement  
Drilling mud to 210' - Plug 1/2 sackhulls and  
20 sacks cement.  
Drilling mud to 40', plug 1/2 sack hulls  
8 sacks cement and 2 sacks cement in Rathole

RECEIVED  
STATE CORPORATION COMMISSION  
MAY 5 - 1966  
5-5-66  
CONSERVATION DIVISION  
Wichita, Kansas

(If additional description is necessary, use BACK of this sheet)

Name of Plugging Contractor Thoroughbred Drilling Company

Address Ritz Building, Tulsa, Oklahoma

STATE OF OKLAHOMA COUNTY OF TULSA, ss.

Dan W. Brown, Thoroughbred Drlg. Co. (employee of owner) or (owner or operator) of the above-described well, being first duly sworn on oath, says: That I have knowledge of the facts, statements, and matters herein contained and the log of the above-described well as filed and that the same are true and correct. So help me God.

(Signature) Dan W. Brown

Ritz Building, Tulsa, Oklahoma

(Address)

SUBSCRIBED AND SWORN TO before me this 2nd day of May, 1966

Maxine D. Provine  
Maxine D. Provine

Notary Public.

My commission expires February 21, 1969