

15-163-20950-00-00


STATE OF KANSAS
STATE CORPORATION COMMISSION

WELL PLUGGING RECORD

Give All Information Completely
Make Required Affidavit
Mail or Deliver Report to
Conservation Division
State Corporation Comm.
245 North Water
Wichita, KS 67202

Rooks County, Sec. 32 Twp. 6 Rge. 17 E/W
Location as "NE/CNW $\frac{1}{4}$ SW $\frac{1}{4}$ " or footage from lines
990 W. line 585 N. line (E/2 NW SW)
Lease Owner Thomas E. Brown (Gene Brown Co.)
Lease Name Dix Well No. 1

Office Address Plainville, Kansas 67663
Character of Well (Completed as Oil, Gas or Dry Hole)
dry hole

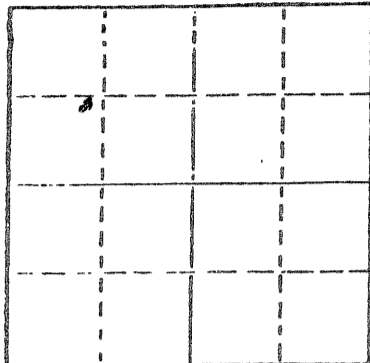

Date Well completed July 28, 1979 19
Application for plugging filed July 28, 1979 19
Application for plugging approved July 27, 1979 19
Plugging commenced 1:00 P. M. July 27, 1979 19
Plugging completed 2:15 P. M. July 27, 1979 19
Reason for abandonment of well or producing formation
none commercial

If a producing well is abandoned, date of last production 19

Was permission obtained from the Conservation Division or its agents before plugging was commenced? yes

Name of Conservation Agent who supervised plugging of this well H. Schmidt
Producing formation none Depth to top na Bottom na Total Depth of Well 3,372
Show depth and thickness of all water, oil and gas formations.

OIL, GAS OR WATER RECORDS

CASING RECORD

FORMATION	CONTENT	FROM	TO	SIZE	PUT IN	PULLED OUT
sand and shale	surface	0	170	8 5/8	170 ft.	none

Describe in detail the manner in which the well was plugged, indicating where the mud fluid was placed and the method or methods used in introducing it into the hold. If cement or other plugs were used, state the character of same and depth placed, from 640 feet to 160 feet for each plug set. 40 ft.
70 sacks at 640 ft. 20 sacks at 160 ft. 10 sacks and 1 sack of hulls and 1 bridge plug 3 sacks for rat hole. Total cement 160 sacks 50/50 poz 6% gel.

RECEIVED
STATE CORPORATION COMMISSION

JUL 31 1979

(If additional description is necessary, use BACK of this sheet)
Name of Plugging Contractor Allied Cement
7-31-79
CONSERVATION DIVISION
Wichita, Kansas

STATE OF Kansas COUNTY OF Osborne, ss.
R. L. Finnesy (employee of owner) or (owner or operator)
of the above-described well, being first duly sworn on oath, says: That I have knowledge of the facts, statements, and matters herein contained and the log of the above-described well as filed and that the same are true and correct. So help me God.

(Signature) R. L. Finnesy
(Address)

SUBSCRIBED AND SWORN TO before me this 30th day of July, 1979

My commission expires January 13-1980
Paul E. Ruggels Notary Public.

