


STATE OF KANSAS
STATE CORPORATION COMMISSION

WELL PLUGGING RECORD

Give All Information Completely
Make Required Affidavit
Mail or Deliver Report to
Conservation Division
State Corporation Comm.
245 North Water
Wichita, KS 67202

Rooks County, Sec. 32 Twp. 6 Rge. 17w E/W
Location as "NE/CNW $\frac{1}{4}$ SW $\frac{1}{4}$ " or footage from lines (330')
NW-NW-SW
Lease Owner Two-Way Oil Company
Lease Name Dix Well No. 1
Office Address 407 S. Main Plainville, Ks. 67653
Character of Well (Completed as Oil, Gas or Dry Hole)

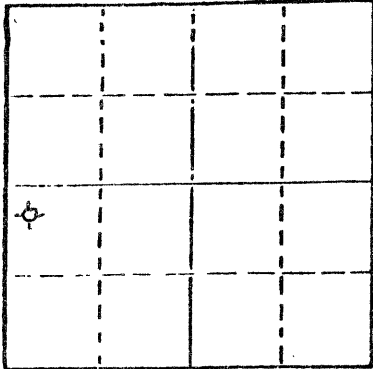

Locate well correctly on above
Section Plat

Dry Hole
Date Well completed Jan. 13 1979
Application for plugging filed Jan. 13 1979
Application for plugging approved Jan. 13 1979
Plugging commenced Jan. 13 1979
Plugging completed Jan. 13 1979
Reason for abandonment of well or producing formation

Dry Hole
If a producing well is abandoned, date of last production 19

Was permission obtained from the Conservation Division or its agents before plugging was commenced? Yes

Name of Conservation Agent who supervised plugging of this well Gilbert Balitzor
Producing formation _____ Depth to top _____ Bottom _____ Total Depth of Well 3165
Show depth and thickness of all water, oil and gas formations.

OIL, GAS OR WATER RECORDS

CASING RECORD

FORMATION	CONTENT	FROM	TO	SIZE	PUT IN	PULLED OUT
Surface		0'	179'	8 5/8"	179'	0'

Describe in detail the manner in which the well was plugged, indicating where the mud fluid was placed and the method or methods used in introducing it into the hold. If cement or other plugs were used, state the character of same and depth placed, from _____ feet to _____ feet for each plug set.

- 1 st. plug at 600' with 70 sacks common 50-50% Poz. 6% Gel.
- 2 nd. plug at 180' with 20 sacks common 50-50% Poz. 6% Gel.
- 3rd. plug at 40' with 10 sacks common 50-50% Poz. 6% Gel.

RECEIVED
STATE CORPORATION COMMISSION

JAN 31 1979

(If additional description is necessary, use BACK of this sheet)
Name of Plugging Contractor Allied Cementing Co., Inc. 1-31-79
CONSERVATION DIVISION
Wichita, Kansas

STATE OF Kansas COUNTY OF Graham, ss.
Jerry M. Helberg (employee of owner) or (owner or operator)
of the above-described well, being first duly sworn on oath, says: That I have knowledge of the facts, statements, and matters herein contained and the log of the above-described well as filed and that the same are true and correct. So help me God.

(Signature) Jerry M. Helberg
Box 32 Morland, Ks. 67650
(Address)

SUBSCRIBED AND SWORN TO before me this 30th day of January, 1979

Notary Public.

My commission expires 12-4-79

