

STATE OF KANSAS
STATE CORPORATION COMMISSION

15-163-20083-00-00


Form CP-4

Give All Information Completely
Make Required Affidavit
Mail or Deliver Report to:
Conservation Division
State Corporation Commission
212 No. Market
Wichita, Kansas 67202

WELL PLUGGING RECORD

Range 32 County SE Sec. 6 Twp. 17W (E) (W)

Location as "NE/CNW/SW" or footage from lines SE SE NW
Lease Owner National Associated Petroleum Co.
Lease Name George Duncan #1 Well No. _____
Office Address Tulsa, Oklahoma
Character of Well (completed as Oil, Gas or Dry Hole) _____
Date well completed _____ 19____
Application for plugging filed _____ 19____
Application for plugging approved _____ 19____
Plugging commenced 10/29/69 _____ 19____
Plugging completed 10/29/69 _____ 19____
Reason for abandonment of well or producing formation depleted.

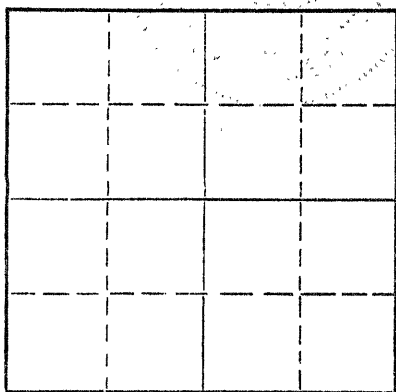

Locate well correctly on above
Section Plat

If a producing well is abandoned, date of last production _____ 19____
Was permission obtained from the Conservation Division or its agents before plugging was commenced? yes

Name of Conservation Agent who supervised plugging of this well Massey
Producing formation _____ Depth to top _____ Bottom _____ Total Depth of Well 3366' Feet
Show depth and thickness of all water, oil and gas formations.

OIL, GAS OR WATER RECORDS

CASING RECORD

FORMATION	CONTENT	FROM	TO	SIZE	PUT IN	PULLED OUT
				8-5/8	208	none
				5-1/2"	3366'	none

Describe in detail the manner in which the well was plugged, indicating where the mud fluid was placed and the method or methods used in introducing it into the hole. If cement or other plugs were used, state the character of same and depth placed, from _____ feet to _____ feet for each plug set.

Pumped 4 sacks hulls, 20 sacks gel mud and 70 sacks of cement to plug well.

PLUGGING COMPLETE.

RECEIVED
STATE CORPORATION COMMISSION
NOV 5 1969
CONSERVATION DIVISION
Wichita, Kansas

11-5-69

(If additional description is necessary, use BACK of this sheet)

Name of Plugging Contractor KNIGHT CASING PULLING CO., INC.
Address CHASE, KANSAS


STATE OF KANSAS, COUNTY OF RICE, ss. NOEL J. Knight

(employee of owner) or (owner or operator) of the above-described well, being first duly sworn on oath, says: That I have knowledge of the facts, statements, and matters herein contained and the log of the above-described well as filed and that the same are true and correct. So help me God.

(Signature) Noel Knight

Chase, Kansas 67524
(Address)

SUBSCRIBED AND SWORN to before me this 31st day of October, 19 69

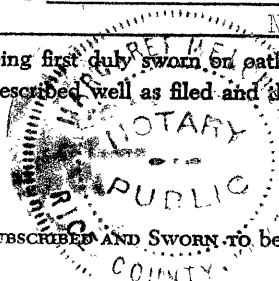

My commission expires 2/15/71

Margaret Melches
Notary Public.