

15-163-30181-00-00

STATE OF KANSAS  
STATE CORPORATION COMMISSION

Form CP-4

Give All Information Completely  
Make Required Affidavit  
Mail or Deliver Report to:  
Conservation Division  
State Corporation Commission  
212 No. Market  
Wichita, Kansas

WELL PLUGGING RECORD

Rooks

County. Sec. 31 Twp. 6S Rge. (E) 17 (W)

Location as "NE/CNW/SW" or footage from lines SE/4 NE/4 SE/4

Lease Owner Forrest H. Lindsay - National Associated Petroleum

Lease Name N. G. Riffel Well No. 1

Office Address 502 Ritz Building, Tulsa, Oklahoma

Character of Well (completed as Oil, Gas or Dry Hole) Dry Hole

Date well completed April 2 1966

Application for plugging April 2 (Verbal) - April 2 1966

Application for plugging approved April 2 (Verbal) 1966


Plugging commenced April 2 1966

Plugging completed April 2 1966

Reason for abandonment of well or producing formation Dry Hole

If a producing well is abandoned, date of last production \_\_\_\_\_ 19\_\_\_\_

Was permission obtained from the Conservation Division or its agents before plugging was commenced? Yes

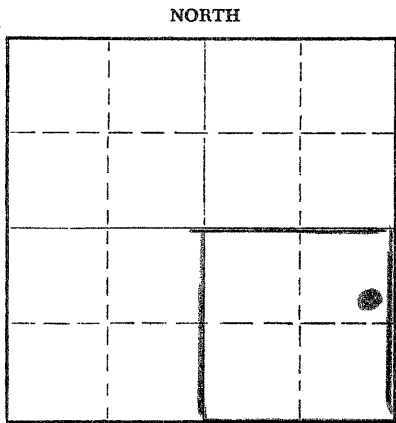

Locate well correctly on above Section Plat

Name of Conservation Agent who supervised plugging of this well \_\_\_\_\_

Producing formation \_\_\_\_\_ Depth to top \_\_\_\_\_ Bottom \_\_\_\_\_ Total Depth of Well 3322 Feet

Show depth and thickness of all water, oil and gas formations.

OIL, GAS OR WATER RECORDS

CASING RECORD

FORMATION	CONTENT	FROM	TO	SIZE	PUT IN	PULLED OUT

Describe in detail the manner in which the well was plugged, indicating where the mud fluid was placed and the method or methods used in introducing it into the hole. If cement or other plugs were used, state the character of same and depth placed, from \_\_\_\_\_ feet to \_\_\_\_\_ feet for each plug set.

Plug @ 540' W/20 sacks cement  
Mud to 180' - Plug with 1/2 sacks hulls and 20 sacks cement  
Mud to 40' - Plug with 1/2 sack hulls and 8 sacks cement  
2 sacks cement in Rathole

RECEIVED  
STATE CORPORATION COMMISSION

APR 13 1966

4-13-66

CONSERVATION DIVISION  
WICHITA, KANSAS

(If additional description is necessary, use BACK of this sheet)

Name of Plugging Contractor Thoroughbred Drilling Company

Address 517 Ritz Building, Tulsa, Oklahoma

STATE OF OKLAHOMA, COUNTY OF TULSA, ss.

Dan W. Brown, Thoroughbred Drilling Company (employee of owner) or (owner or operator) of the above-described well, being first duly sworn on oath, says: That I have knowledge of the facts, statements, and matters herein contained and the log of the above-described well as filed and that the same are true and correct. So help me God.

(Signature) Dan W. Brown

517 Ritz Building, Tulsa, Oklahoma

(Address)

SUBSCRIBED AND SWORN to before me this 11th day of April, 1966

Maxine D. Provine  
Maxine D. Provine

Notary Public.

My commission expires February 21, 1969