

15-163-00027-00-00

STATE OF KANSAS
STATE CORPORATION COMMISSION

WELL PLUGGING RECORD


Give All Information Completely
Make Required Affidavit
Mail or Deliver Report to:
Conservation Division
State Corporation Commission
800 Bittling Building
Wichita, Kansas

OR

~~FORMATION PLUGGING RECORD~~

Strike out upper line when reporting plugging off formations.

NORTH

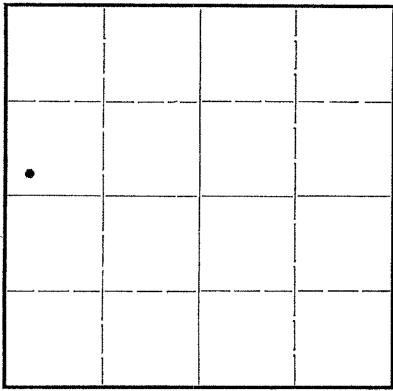

Locate well correctly on above Section Plat

Rooks County. Sec. 25 Twp. 6S Rge. (E) 17 (W)
Location as "NE 1/4 NW 1/4 SW 1/4" or footage from lines. SW/4 NW/4, 330' fm Sth & West lines.
Lease Owner. Sinclair Prairie Oil Co
Lease Name. Lila M. Fry Well No. 1
Office Address. Bx 521, Tulsa, Okla.
Character of Well (completed as Oil, Gas or Dry Hole) dry hole
Date well completed. November 22 1944
Application for plugging filed. Dec. 5, 1944 19
Application for plugging approved. Dec. 4, 1944 19
Plugging commenced. November 23 1944
Plugging completed. " " 1944
Reason for abandonment of well or producing formation. dry hole completion

If a producing well is abandoned, date of last production. - 19
Was permission obtained from the Conservation Division or its agents before plugging was commenced? yes

Name of Conservation Agent who supervised plugging of this well. H.W. Kerr
Producing formation. Arbuckle Depth to top. 5570 Bottom. Total Depth of Well 3628 Feet
Show depth and thickness of all water, oil and gas formations.


OIL, GAS OR WATER RECORDS

CASING RECORD

Formation	Content	From	To	Size	Put In	Pulled Out
Arbuckle	dry			9-5/8"	613'	0
					NO MATERIAL RECOVERED	

Describe in detail the manner in which the well was plugged, indicating where the mud fluid was placed and the method or methods used in introducing it into the hold. If cement or other plugs were used, state the character of same and depth placed, from feet to feet for each plug set.

- 3628' - 613' heavy mud
- 613' - 580' wood plug & 15 sx cmt
- 580' - 36' heavy mud
- 36' - 6' 15 sx cmt.
- 6' - 0 mud to surface

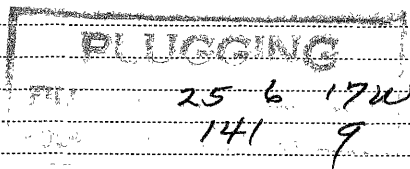

(If additional description is necessary, use BACK of this sheet)

Correspondence regarding this well should be addressed to Victor Chancellor
Address. Bx 774, Great Bend, Kans.

STATE OF Kansas, COUNTY OF Barton, ss.
I, Victor Chancellor (employee of owner) or (owner) of the above-described well, being first duly sworn on oath, says: That I have knowledge of the facts, statements, and matters herein contained and the log of the above-described well as filed and that the same are true and correct. So help me God.

(Signature) Victor Chancellor
Box 774, Great Bend, Kans.
(Address)

SUBSCRIBED AND SWORN to before me this 6th day of December 1944
Notary Public.

My commission expires 6-14-47

