

15-163-30167-00-00

WELL PLUGGING RECORD

Give All Information Completely
Make Required Affidavit
Mail or Deliver Report to:
Conservation Division
State Corporation Commission
211 No. Broadway
Wichita, Kansas

ROOKS

County. Sec. 18 Twp. 6S Rge. (E) (W) 17

Location as "NE/CNW*SW*" or footage from lines. SW SW NW

Lease Owner NATIONAL ASSOCIATED PETROLEUM CO.

Lease Name MARY F. SCHWARZ "B" Well No. 1

Office Address FIFTH FLOOR RITZ BLDG., TULSA, OKLAHOMA

Character of Well (completed as Oil, Gas or Dry Hole) D & A

Date well completed 5/12/66 19

Application for plugging filed 5/12/66 verbal 19

Application for plugging approved same 19


Plugging commenced same 19

Plugging completed same 19

Reason for abandonment of well or producing formation No oil

If a producing well is abandoned, date of last production 19

Was permission obtained from the Conservation Division or its agents before plugging was commenced? Yes

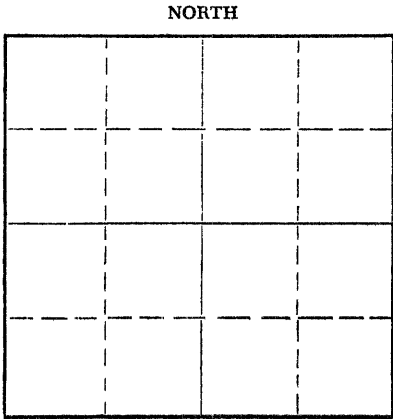

Locate well correctly on above Section Plat

Name of Conservation Agent who supervised plugging of this well

Producing formation Depth to top Bottom Total Depth of Well 3411 Feet

Show depth and thickness of all water, oil and gas formations.

OIL, GAS OR WATER RECORDS

CASING RECORD

FORMATION	CONTENT	FROM	TO	SIZE	PUT IN	PULLED OUT

Describe in detail the manner in which the well was plugged, indicating where the mud fluid was placed and the method or methods used in introducing it into the hole. If cement or other plugs were used, state the character of same and depth placed, from feet to feet for each plug set.

Lay down drill pipe plug hole Mud to 540' -
20 sks cement mud to 200' 1/4 sks hulls plug
& 20 sks cement mud to 40' 1/4 sks hulls plug
8 sks cement - - 2 sks in rat hole
plug @ 7:00 P.M.

RECEIVED
STATE CORPORATION COMMISSION
AUG 8 1966
CONSERVATION DIVISION
Wichita, Kansas

8-8-66

(If additional description is necessary, use BACK of this sheet)

Name of Plugging Contractor Thoroughbred Drilling Co.
Address 517 Ritz Bldg., Tulsa, Oklahoma

STATE OF Oklahoma, COUNTY OF Tulsa, ss.

(employee of owner) or (owner or operator) of the above-described well, being first duly sworn on oath, says: That I have knowledge of the facts, statements, and matters herein contained and the log of the above-described well as filed and that the same are true and correct. So help me God.

(Signature) Dan W. Brown

Dan W. Brown 517 Ritz Bldg., Tulsa (Address)

SUBSCRIBED AND SWORN TO before me this 5th day of August, 1966

My commission expires February 21, 1969

Margie D. Province Notary Public.

