


STATE OF KANSAS
STATE CORPORATION COMMISSION

WELL PLUGGING RECORD

Give All Information Completely
Make Required Affidavit
Mail or Deliver Report to
Conservation Division
State Corporation Comm.
245 North Water
Wichita, KS 67202

Rooks County, Sec. 36 Twp. 6 Rge. 16 E/W.
Location as "NE/CNW $\frac{1}{4}$ SW $\frac{1}{4}$ " or footage from lines

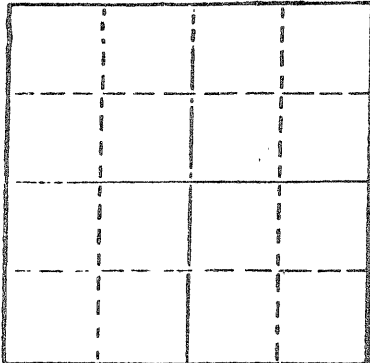

Locate well correctly on above
Section Plat

SW SW NW
Lease Owner Blue Danube Exploration
Lease Name Thomas Well No. 1
Office Address Box 349 Natoma, Kansas 67651
Character of Well (Completed as Oil, Gas or Dry Hole)
Non-commercial oil
Date Well completed 1/13/80 19
Application for plugging filed 1/13/80 19
Application for plugging approved 1/13/80 19
Plugging commenced 4:30 A. M. 19
Plugging completed 6:00 A. M. 19
Reason for abandonment of well or producing formation
non-commercial
If a producing well is abandoned, date of last production 19

Was permission obtained from the Conservation Division or
its agents before plugging was commenced? yes

Name of Conservation Agent who supervised plugging of this well Marion Schmidt
Producing formation none Depth to top Bottom Total Depth of Well
Show depth and thickness of all water, oil and gas formations.

OIL, GAS OR WATER RECORDS

CASING RECORD

FORMATION	CONTENT	FROM	TO	SIZE	PUT IN	PULLED OUT

Describe in detail the manner in which the well was plugged, indicating where the mud fluid
was placed and the method or methods used in introducing it into the hold. If cement or other
plugs were used, state the character of same and depth placed, from feet to
feet for each plug set.

1st plug 70 sacks at 690'
2nd plug 20 sacks at 150'
3rd plug 10 sacks at 40'
5 sacks in rathole

Total 111 sacks common-53 sacks Pozmix 52 sacks Gel 6 sacks

RECEIVED
STATE CORPORATION COMMISSION
JAN 21 1980
CONSERVATION DIVISION
Wichita, Kansas

(If additional description is necessary, use BACK of this sheet)

Name of Plugging Contractor Lawbanco, Drilling, Inc.
Box 289 Natoma, Kansas 67651

STATE OF Kansas COUNTY OF Osborne, ss. R. L. Finnesy (employee of owner) or (owner or operator)

of the above-described well, being first duly sworn on oath, says: That I have knowledge of
the facts, statements, and matters herein contained and the log of the above-described well
as filed and that the same are true and correct. So help me God.

(Signature) R. L. Finnesy
207 SW 8th Street Plainville, Kans 67651
(Address)

SUBSCRIBED AND SWORN TO before me this 18th day of January, 1980

Linda A. Zeigler
Notary Public.

My commission expires 8-29-83

