

15-163-02540-00-00

STATE OF KANSAS  
STATE CORPORATION COMMISSION

WELL PLUGGING RECORD


OR  
FORMATION PLUGGING RECORD

Strike out upper line  
when reporting plug-  
ging off formations.

Give All Information Completely  
Make Required Affidavit  
Mail or Deliver Report to:  
Conservation Division  
State Corporation Commission  
800 Bittling Building  
Wichita, Kansas

County. Sec. 16 Twp. 6 Rge. (E) 17 (W)

Location as "NE $\frac{1}{4}$ NW $\frac{1}{4}$ SW $\frac{1}{4}$ " or footage from lines SE C NE NE  
Lease Owner National Associated Petroleum  
Lease Name Riley Well No. 1  
Office Address Tulsa, Oklahoma  
Character of Well (completed as Oil, Gas or Dry Hole) Dry  
Date well completed 8-29-43 19  
Application for plugging filed 8-29-43 19  
Application for plugging approved 8-29-43 19  
Plugging commenced 8-29-43 19  
Plugging completed 8-29-43 19  
Reason for abandonment of well or producing formation  
Dry hole

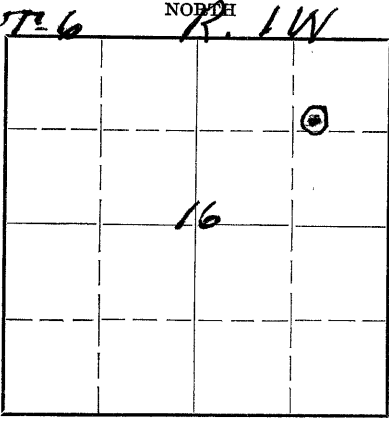

Locate well correctly on above  
Section Plat

If a producing well is abandoned, date of last production 19  
Was permission obtained from the Conservation Division or its agents before plugging was com-  
menced? Yes

Name of Conservation Agent who supervised plugging of this well C. T. Alexander  
Producing formation Depth to top Bottom Total Depth of Well 3666 Feet  
Show depth and thickness of all water, oil and gas formations.

OIL, GAS OR WATER RECORDS

CASING RECORD

Formation	Content	From	To	Size	Put In	Pulled Out
				10-3/4"	208	None

Describe in detail the manner in which the well was plugged, indicating where the mud fluid was placed and the method or methods used in introducing it into the hold. If cement or other plugs were used, state the character of same and depth placed, from feet to feet for each plug set.

Heavy mud circulated from 3666' to 208'. Cement plug from 208' to 178'. Mud from 178' to 20'. Cement from 20' to 5'. All mud pumped in through drill pipe

FILED 16 6 17W  
OCT 28 1943  
PAGE 89 41

(If additional description is necessary, use BACK of this sheet)

Correspondence regarding this well should be addressed to National Associated Petroleum Company 1028-43  
Address Tulsa, Oklahoma

STATE OF OKLAHOMA, COUNTY OF TULSA, SS.  
I, Harry Saye, (employee of owner) or (owner or operator) of the above-described well,

being first duly sworn on oath, says: That I have knowledge of the facts, statements, and matters herein contained and the log of the above-described well as filed and that the same are true and correct. So help me God.

(Signature) Harry Saye  
Production Superintendent  
(Address)

SUBSCRIBED AND SWORN TO before me this 25th day of October 19 43

My commission expires July 22, 1947

Joe Griffin  
Notary Public.

15-163-02340-00-00

Riley #1  
SE Corner NE/4 NE/4 of Section 16-8S-17W,  
Rooks County, Kansas  
National Associated Petroleum Company

Commenced: August 11, 1943  
Completed: August 30, 1943

Surface rock and clay	0	60
Shale and shells	60	130
Sand	130	190
Shale and shells	190	270
Blue shale and shells	270	700
Sand and shale	700	770
Shale, sand and shells	770	950
Sand	950	980
Sand and shale	980	1425
Anhydrite	1425	1455
Shale and shells	1455	1495
Shale and red bed	1495	1715
Shale and gyp	1715	1820
Shale and lime	1820	1930
Shale and lime shells	1930	2030
Shale and shells	2030	2145
Shale and lime	2145	2515
Shale and lime shells	2515	2555
Shale	2555	2605
Shale and lime	2605	2655
Shale and little lime	2655	2735
Shale and lime	2735	2985
Lime	2985	3015
Lime and shale	3015	3085
Lime (K.C.)	3085	3120
Lime	3120	3200
Cherty lime	3200	3232
Lime	3232	3261
Shale	3261	3270
Lime and shale	3270	3343
Lime	3343	3425
Lime and conglomerate	3425	3455
Conglomerate	3455	3550
Conglomerate (cherty)	3550	3615
Arbuckle	3615	3665
TOTAL DEPTH	3665	

CASING RECORD

10-3/4" casing set at 208' and cemented with 150 sacks of cement.

STATE OF OKLAHOMA )  
                                  ss  
COUNTY OF TULSA )

I hereby affirm that the above and foregoing is a true and correct copy of the log of your Riley Well #1, located in the <sup>SE</sup> corner of the Northeast Quarter of the Northeast Quarter of Section 16, Township 6 South, Range 17 West, Rooks County, Kansas.

HELMERICH & PAYNE, INC.  
*William B. Goodhue*  
Treasurer

Subscribed and sworn to before me, a Notary Public, this 8th day of September, 1943.

*Lee Spiffen*  
Notary Public

My commission expires July 22nd, 1947