

15-163-20956-00-00


STATE OF KANSAS
STATE CORPORATION COMMISSION

WELL PLUGGING RECORD

Give All Information Completely
Make Required Affidavit
Mail or Deliver Report to
Conservation Division
State Corporation Comm.
245 North Water
Wichita, KS 67202

Rooks County. Sec. 7 Twp. 6S Rge. 17 NE/W
Location as "NE/CNW $\frac{1}{4}$ SW $\frac{1}{4}$ " or footage from lines
NW SE NW

Lease Owner Pate-Dombaugh, Inc.-Martin Oil
Lease Name Coleman-Brune Well No. #1
Office Address 502 Union Center Wichita, Kansas 67202
Character of Well (Completed as Oil, Gas or Dry Hole) Dry Hole

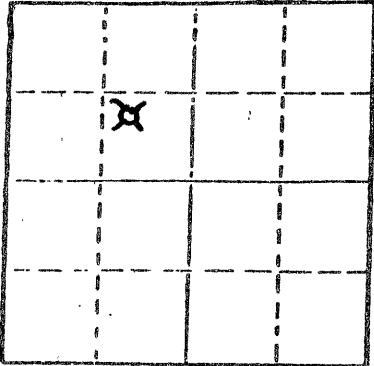

Locate well correctly on above
Section Plat

Date Well completed December 29, 1979
Application for plugging filed December 29, 1979
Application for plugging approved December 29, 1979
Plugging commenced December 29, 9:00 P.M. 1979
Plugging completed December 29, 10:15 P.M. 1979
Reason for abandonment of well or producing formation No Commercial Production

If a producing well is abandoned, date of last production 19

Was permission obtained from the Conservation Division or its agents before plugging was commenced? yes

Name of Conservation Agent who supervised plugging of this well Marion Schmidt
Producing formation _____ Depth to top _____ Bottom _____ Total Depth of Well _____
Show depth and thickness of all water, oil and gas formations.

OIL, GAS OR WATER RECORDS

CASING RECORD

FORMATION	CONTENT	FROM	TO	SIZE	PUT IN	PULLED OUT
surface casing	common	0	240.74'	8 5/8"	240.74'	0

Describe in detail the manner in which the well was plugged, indicating where the mud fluid was placed and the method or methods used in introducing it into the hold. If cement or other plugs were used, state the character of same and depth placed, from _____ feet to _____ feet for each plug set.

- Plug #1 @ 750' with 70 sxs
- Plug #2 @ 235' with 20 sxs
- Plug #3 @ 40' with 10 sxs
- 5 sxs hulls & Solid Bridge
- 1 Wooden plug

RECEIVED
STATE CORPORATION COMMISSION
JAN - 9 1980
CONSERVATION DIVISION
Wichita, Kansas
1-9-80

(If additional description is necessary, use BACK of this sheet)

Name of Plugging Contractor Pioneer Drilling Company, Inc.
308 West Mill Plainville, Kansas 67663

STATE OF KANSAS COUNTY OF SEDGWICK, ss.
Raymond R. Dombaugh (employee of owner) or (owner or operator)
of the above-described well, being first duly sworn on oath, says: That I have knowledge of the facts, statements, and matters herein contained and the log of the above-described well as filed and that the same are true and correct. So help me God.

(Signature) Raymond R. Dombaugh
502 Union Center Bldg. Wichita, Ks. 67202
(Address)

SUBSCRIBED AND SWORN TO before me this 4th day of January, 1980

June K. Burnett
June K. Burnett Notary Public.

My commission expires March 30, 1981

