

CARD MUST BE TYPED

State of Kansas

CARD MUST BE SIGNED

NOTICE OF INTENTION TO DRILL

* CORRECTED

AMENDED

(see rules on reverse side)

Starting Date October 19, 1987 month day year

API Number 15-065-22,415-00-00A

OPERATOR: License # 3214 Name WMA Corporation Address P.O. Box 781713 City/State/Zip Wichita, KS 67271-1713 Contact Person Bernard Hoffman Phone 316-685-2702

* NW SE SE Sec. 6 Twp. 6 S, Rg. 21 East X West 990 Ft. from South Line of Section * 990 Ft. from East Line of Section

(Note: Locate well on Section Plat on reverse side)

CONTRACTOR: License # 5422 Name Abercrombie Drilling, Inc. Wichita, KS

* WAS: NW-SW-SE 2310' FEL

Nearest lease or unit boundary line 330 feet County Graham Lease Name VOSS Well # 1

Well Drilled For: X Oil SWD Infield X Mud Rotary Gas Inj Pool Ext Air Rotary OWWO Expl X Wildcat Cable

Ground surface elevation feet MSL Domestic well within 330 feet: yes X no Municipal well within one mile: yes X no Surface pipe by Alternate: 1 2 X Depth to bottom of fresh water 150' Depth to bottom of usable water 1150' Surface pipe planned to be set 250' Projected Total Depth 3800' feet Formation LKC

If OWWO: old well info as follows: Operator Well Name N/A Comp Date Old Total Depth

I certify that well will comply with K.S.A. 55-101, et seq., plus eventually plugging hole to KCC specifications.

cementing will be done immediately upon setting production casing. Date 10-15-87 Signature of Operator or Agent Title Agent


For KCC Use: Conductor Pipe Required feet: Minimum Surface Pipe Required 200 feet per Alt. This Authorization Expires 4-13-88 Effective 10-18-87 Approved By 10-16-87 OR16 RCW10-13-87

Must be filed with the K.C.C. five (5) days prior to commencing well
 This card void if drilling not started within six (6) months of date received by K.C.C.

Important procedures to follow:

1. Notify District office before setting surface casing.
2. Set surface casing by circulating cement to the top.
3. File completion forms ACO-1 with K.C.C. within 90 days of well completion, following instructions on ACO-1, side 1, and including copies of wireline logs.
4. Notify District office 48 hours prior to old well workover or re-entry.
5. Prior to filing Intent, prepare a proposed plugging plan in case well is D & A, then obtain approval of plan when calling district office prior to setting surface pipe.
6. Submit plugging report (CP-4) to K. C. C. after plugging is completed.
7. Obtain an approved injection docket number before disposing of salt water.
8. Notify K.C.C. within 10 days when injection commences or terminates.
9. If an alternate 2 completion, cement in the production pipe from below any usable water to surface within 120 days of spud date.

A Regular Section of Land
1 Mile = 5,280 Ft.

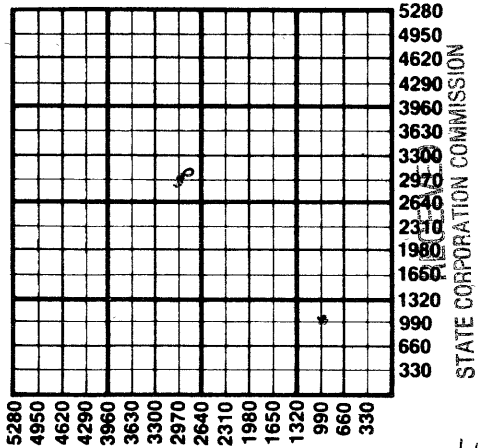

State Corporation Commission of Kansas
 Conservation Division
 200 Colorado Derby Building
 Wichita, Kansas 67202
 (316) 263-3238