

CARD MUST BE TYPED

State of Kansas

CARD MUST BE SIGNED

NOTICE OF INTENTION TO DRILL

(see rules on reverse side)

Expected Spud Date..... 11 5 88  
month day year  
5004

API Number 15- 065-22,498 -00-0010  
C  
E/2 NE NE Sec. 7 Twp. 6 S, Rg. 21 East  
4620 West  
330  
Ft. from South Line of Section  
Ft. from East Line of Section

OPERATOR: License #  
Name Vincent Oil Corporation  
Address 125 No. Market, Suite 1110  
City/State/Zip Wichita, Kansas 67202  
Contact Person Julie K. Stout  
Phone (316) 262-3573

(Note: Locate well on Section Plat on reverse side)  
Nearest lease or unit boundary line 660 feet  
County Graham  
Lease Name Harvey Well # 5

CONTRACTOR: License # 4958  
Name Mallard, J.V., Inc.  
City/State McPherson, Kansas 67460

Ground surface elevation applied for feet MSL  
Domestic well within 330 feet: \_\_\_yes Xno  
Municipal well within one mile: \_\_\_yes Xno  
Depth to bottom of fresh water. 100 80 feet  
Depth to bottom of usable water Dakota 1300 feet  
Surface pipe by Alternate: 1 \_\_\_ 2 X

Well Drilled For: Well Class: Type Equipment:  
X Oil \_\_\_ Storage X Infield X Mud Rotary  
\_\_\_ Gas \_\_\_ Inj \_\_\_ Pool Ext. \_\_\_ Air Rotary  
\_\_\_ OWWO \_\_\_ Expl \_\_\_ Wildcat \_\_\_ Cable

Surface pipe planned to be set 240 feet  
Conductor pipe required n/a  
Projected Total Depth 3700 feet  
Formation Arbuckle

If OWWO: old well info as follows:

Operator  
Well Name  
Comp Date Old Total Depth

I certify that well will comply with K.S.A. 55-101, et seq., plus eventually plugging hole to KCC specifications.

Date 11-2-88 Signature of Operator or Agent Richard A. Hiebsch Title Vice President

For KCC Use:

Conductor Pipe Required \_\_\_\_\_ feet; Minimum Surface Pipe Required 200' feet per Alt. X 2  
This Authorization Expires 5-2-89 Approved By LKM 11-2-88


EFFECTIVE DATE: 11-7-88

Must be filed with the K.C.C. five (5) days prior to commencing well  
This card void if drilling not started within six (6) months of date received by K.C.C.

**Important procedures to follow:**

1. Notify District office before setting surface casing.
2. Set surface casing by circulating cement to the top.
3. File completion forms ACO-1 with K.C.C. within 120 days of well spud date, following instructions on ACO-1, side I, and including copies of wireline logs.
4. Notify District office 48 hours prior to old well workover or re-entry.
5. Prior to filing Intent, prepare a proposed plugging plan in case well is D & A, then obtain approval of plan when calling district office prior to setting surface pipe.
6. Submit plugging report (CP-4) to K.C.C. after plugging is completed.
7. Obtain an approved injection docket number before disposing of salt water.
8. Notify K.C.C. within 10 days when injection commences or terminates.
9. If you alternate 2 completion, cement in the production pipe from below any usable water to surface within 120 days of spud date.

**A Regular Section of Land**  
**1 Mile = 5,280 Ft.**

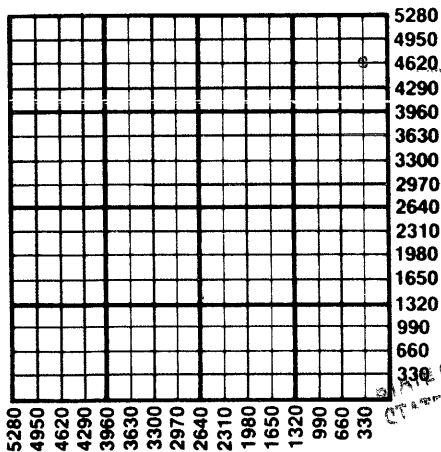

RECEIVED  
STATE CORPORATION COMMISSION  
NOV 2 1988  
CONSERVATION DIVISION  
Wichita, Kansas  
11-2-88

State Corporation Commission of Kansas  
Conservation Division  
200 Colorado Derby Building  
Wichita, Kansas 67202-1212  
(316) 263-3238