

CARD MUST BE TYPED

State of Kansas
NOTICE OF INTENTION TO DRILL
(see rules on reverse side)

CARD MUST BE SIGNED

Starting Date: October 29, 1984
month day year

API Number 15- 065-22,099-00-00

OPERATOR: License # 5242
Name Petroleum Management, Inc.
Address 40.0 N. Woodlawn, Suite 201
City/State/Zip Wichita, KS 67208
Contact Person Dale Silcott
Phone 686-7287

SE SW NW Sec 9 Twp 6 S, Rge 21 East West
(location)

CONTRACTOR: License # 5302
Name Red Tiger Drilling Co.
City/State Wichita, KS 67202

2700 Ft North from Southeast Corner of Section
4030 Ft West from Southeast Corner of Section
(Note: Locate well on Section Plat on reverse side)

Nearest lease or unit boundary line 1250' FWL feet.
County Graham

Lease Name VOSS "C" Well# 1

Domestic well within 330 feet: yes no

Municipal well within one mile: yes no

Well Drilled For: Well Class: Type Equipment:
 Oil Swd Infield Mud Rotary
 Gas Inj Pool Ext. Air Rotary
 OWWO Expl Wildcat Cable

Depth to Bottom of fresh water 145 feet

Lowest usable water formation Dakota

Depth to Bottom of usable water 1125 feet

Surface pipe by Alternate: 1 2

Surface pipe to be set 250 feet

Conductor pipe if any required _____ feet

Ground surface elevation 2257 feet MSL

This Authorization Expires 4-26-85

Approved By 10-26-84 [Signature]

I certify that we will comply with K.S.A. 55-101, et seq., plus eventually plugging hole to K.C.C. specifications.

Date 10/22/84 Signature of Operator or Agent

[Signature: Dale Silcott] Title

Vice President

[Signature: MHC/KIDNE 10/22/84] Form C-1 4/84


RECEIVED
STATE CORPORATION COMMISSION

Must be filed with the K.C.C. five (5) days prior to commencing well
This card void if drilling not started within six (6) months of date received by K.C.C.

OCT 26 1984

A Regular Section of land
1 Mile 5,280 Ft.

10-26-84

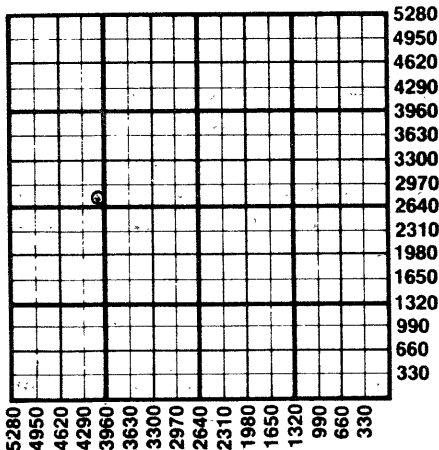

Important procedures to follow :

1. Notify District office before setting surface casing.
2. Set surface casing by circulating cement to the top.
3. File completion forms ACO-1 with K.C.C. within 90 days of well completion, following instructions on ACO-1, side 1, and including copies of wireline logs.
4. Notify District office 48 hours prior to old well workover or re-entry.
5. Prior to plugging, prepare a plugging plan, then obtain agreement from the appropriate district office for an approved plugging plan.
6. Submit plugging report (CP-4) to K.C.C. after plugging is completed.
7. Obtain an approved injection docket number before disposing of salt water.
8. Notify K.C.C. within 10 days when injection commences or terminates.
9. If an alternate 2 completion, cement in the production pipe from below any usable water to surface within 120 days of spud date.

State Corporation Commission of Kansas
Conservation Division
200 Colorado Derby Building
Wichita, Kansas 67202
(316) 263-3238