

CARD MUST BE TYPED

State of Kansas
NOTICE OF INTENTION TO DRILL
(see rules on reverse side)

CARD MUST BE SIGNED

Starting Date: December 11, 1984
month day year

065-22,124-00-00

OPERATOR: License # 5242
Name Petroleum Management, Inc.
Address 400 N. Woodlawn, Suite 201
City/State/Zip Wichita, Ks. 67208
Contact Person Dale Silcott
Phone 686-7287

CONTRACTOR: License # 5302
Name Red Tiger Drilling Co.
City/State Wichita, Ks. 67202

Well Drilled For: Well Class: Type Equipment:
 Oil Swd Infield Mud Rotary
 Gas Inj Pool Ext. Air Rotary
 OWWO Expl Wildcat Cable

API Number 15-
660' S FNL/330' E FWL East
W/2 NW NE/4 Sec 15 Twp 6 S, Rge 21 West
(location)

4620' Ft North from Southeast Corner of Section
2310' Ft West from Southeast Corner of Section
(Note: Locate well on Section Plat on reverse side)

Nearest lease or unit boundary line 2310 feet.
County Graham
Lease Name Eva Desbien Well# 3
Domestic well within 330 feet: yes no
Municipal well within one mile: yes no

Depth to Bottom of fresh water 140 feet
Lowest usable water formation Dakota
Depth to Bottom of usable water 1125 feet
Surface pipe by Alternate: 1 2
Surface pipe to be set 250 feet
Conductor pipe if any required --- feet
Ground surface elevation 2150 feet MSL
This Authorization Expires 6-6-85
Approved By 12-6-84 [Signature]

I certify that we will comply with K.S.A. 55-101, et seq., plus eventually plugging hole to K.C.C. specifications.

Date 12/6/84 Signature of Operator or Agent

[Signature: Dale Silcott]

Title Vice President


MHC/KOHE 12/6/84

RECEIVED
 STATE CORPORATION COMMISSION
 Must be filed with the K.C.C. five (5) days prior to commencing well
 This card void if drilling not started within six (6) months of date received by K.C.C.

DEC 6 1984

12-6-84

MINERAL RIGHTS DIVISION
 A Regular Section of Land
 1 Mile = 5,280 Ft.

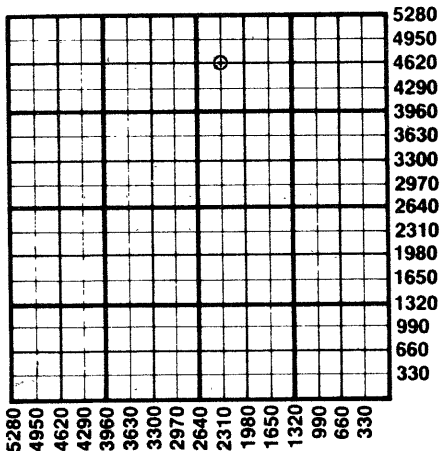

Important procedures to follow:

1. Notify District office before setting surface casing.
2. Set surface casing by circulating cement to the top.
3. File completion forms ACO-1 with K.C.C. within 90 days of well completion, following instructions on ACO-1, side 1, and including copies of wireline logs.
4. Notify District office 48 hours prior to old well workover or re-entry.
5. Prior to plugging, prepare a plugging plan, then obtain agreement from the appropriate district office for an approved plugging plan.
6. Submit plugging report (CP-4) to K.C.C. after plugging is completed.
7. Obtain an approved injection docket number before disposing of salt water.
8. Notify K.C.C. within 10 days when injection commences or terminates.
9. If an alternate 2 completion, cement in the production pipe from below any usable water to surface within 120 days of spud date.

State Corporation Commission of Kansas
 Conservation Division
 200 Colorado Derby Building
 Wichita, Kansas 67202
 (316) 263-3238