

CARD MUST BE TYPED

State of Kansas
NOTICE OF INTENTION TO DRILL
(see rules on reverse side)

CARD MUST BE SIGNED

Starting Date: July 16 1984
month day year

API Number 15-065-22,020000

OPERATOR: License # 5242
Name Petroleum Management, Inc.
Address 400 N. Woodlawn, Suite 201
City/State/Zip Wichita, KS 67208
Contact Person Dale Silcott
Phone 686-7287

SW SE NW Sec 13 Twp 6 S, Rge 21
(location) East West

2970 Ft North from Southeast Corner of Section
3630 Ft West from Southeast Corner of Section
(Note: Locate well on Section Plat on reverse side)

CONTRACTOR: License # 6033
Name Murfin Drilling Co.
City/State Wichita, KS 67202

Nearest lease or unit boundary line 2970 feet.
County Graham
Lease Name Brobst "A" Well# 1

Well Drilled For: Well Class: Type Equipment:
 Oil Swd Infield Mud Rotary
 Gas Inj Pool Ext. Air Rotary
 OWWO Expl Wildcat Cable

Domestic well within 330 feet: yes no
Municipal well within one mile: yes no

Depth to Bottom of fresh water 300 feet
Lowest usable water formation Dakota
Depth to Bottom of usable water 1250 ¹¹⁵⁰ feet
Surface pipe by Alternate: 1 2
Surface pipe to be set 250 320 feet
Conductor pipe if any required None feet
Ground surface elevation 2263 feet MSL
This Authorization Expires ~~7/16/85~~ 11/6/85
Approved By 7/16/84 *R*

If OWWO: old well info as follows:

Operator
Well Name
Comp Date Old Total Depth
Projected Total Depth 3600 feet
Projected Formation at TD Granite
Expected Producing Formations LKC/Arbuckle

I certify that we will comply with K.S.A. 55-101, et seq., plus eventually plugging hole to K.C.C. specifications.

Date 7/3/84 Signature of Operator or Agent Dale Silcott Title Vice President

MHC/KOHE 7-6-84


RECEIVED
STATE CORPORATION COMMISSION

Must be filed with the K.C.C. five (5) days prior to commencing well
This card void if drilling not started within six (6) months of date received by K.C.C.

MAR 06 1984
31-6-84
CONSERVATION DIVISION
Wichita, Kansas

Important procedures to follow:

A Regular Section of Land
1 Mile = 5,280 Ft.

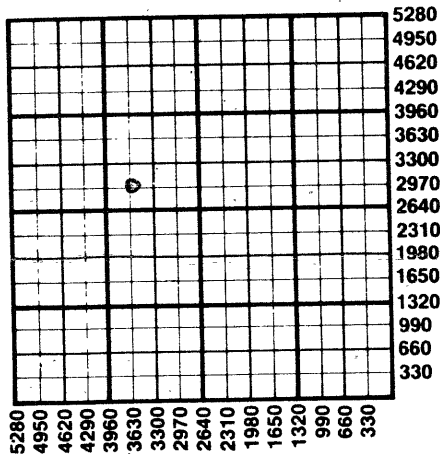

1. Notify District office before setting surface casing.
2. Set surface casing by circulating cement to the top.
3. File completion forms ACO-1 with K.C.C. within 90 days of well completion, following instructions on ACO-1, side 1, and including copies of wireline logs.
4. Notify District office 48 hours prior to old well workover or re-entry.
5. Prior to plugging, prepare a plugging plan, then obtain agreement from the appropriate district office for an approved plugging plan.
6. Submit plugging report (CP-4) to K.C.C. after plugging is completed.
7. Obtain an approved injection docket number before disposing of salt water.
8. Notify K.C.C. within 10 days when injection commences or terminates.
9. If an alternate 2 completion, cement in the production pipe from below any usable water to surface within 120 days of spud date.

State Corporation Commission of Kansas
Conservation Division
200 Colorado Derby Building
Wichita, Kansas 67202
(316) 263-3238