

CARD MUST BE TYPED

State of Kansas

CARD MUST BE SIGNED

NOTICE OF INTENTION TO DRILL

(see rules on reverse side)

Starting Date September 13, 1985
month day year

API Number 15— 065-22,227-0000 East

OPERATOR: License # 5242
Name Petroleum Management, Inc.
Address 400 N. Woodlawn, Suite 201
City/State/Zip Wichita, KS 67208
Contact Person Dale Silcott
Phone 686-7287

SE NW NE Sec. 12 Twp. 6 S, Rg. 21 West
42.90 Ft. from South Line of Section
1650 Ft. from East Line of Section

(Note: Locate well on Section Plat on reverse side)

CONTRACTOR: License # 5302
Name Red Tiger Drilling Company
City/State Wichita, KS 67202

Nearest lease or unit boundary line 330 feet
County Graham
Lease Name Hoylman Well # 3

Well Drilled For: Well Class: Type Equipment:
 Oil SWD Infield Mud Rotary
 Gas Inj Pool Ext. Air Rotary
 OWWO Expl Wildcat Cable

Ground surface elevation 2221 feet MSL
Domestic well within 330 feet: yes no
Municipal well within one mile: yes no
Surface pipe by Alternate: 1 2
Depth to bottom of fresh water 550 ft. ± 100'
Depth to bottom of usable water 25 ft.
Surface pipe planned to be set 360 ft.
Projected Total Depth 3800 feet
Formation Arbuckle

If OWWO: old well info as follows:
Operator
Well Name
Comp Date Old Total Depth

I certify that well will comply with K.S.A. 55-101, et seq., plus eventually plugging hole to KCC specifications.
 cementing will be done immediately upon setting production casing.
Date 8/16/85 Signature of Operator or Agent Dale Silcott Title Vice President


For KCC Use:
Conductor Pipe Required _____ feet; Minimum Surface Pipe Required _____ feet per Alt. 1 2
This Authorization Expires 2-19-86 Approved By RCH 8-19-85

Must be filed with the K.C.C. five (5) days prior to commencing well
 This card void if drilling not started within six (6) months of date received by K.C.C.

Important procedures to follow:

1. Notify District office before setting surface casing.
2. Set surface casing by circulating cement to the top.
3. File completion forms ACO-1 with K.C.C. within 90 days of well completion, following instructions on ACO-1, side 1, and including copies of wireline logs.
4. Notify District office 48 hours prior to old well workover or re-entry.
5. Prior to filing Intent, prepare a proposed plugging plan in case well is D & A, then obtain approval of plan when calling district office prior to setting surface pipe.
6. Submit plugging report (CP-4) to K. C. C. after plugging is completed.
7. Obtain an approved injection docket number before disposing of salt water.
8. Notify K.C.C. within 10 days when injection commences or terminates.

A Regular Section of Land
1 Mile = 5,280 Ft.

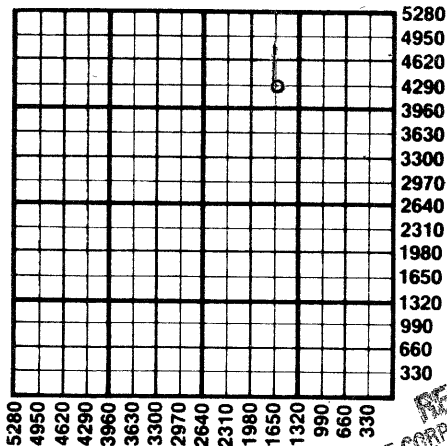

RECEIVED
 STATE CORPORATION COMMISSION
AUG 19 1985
 8-19-85
 CONSERVATION DIVISION
 Wichita, Kansas

If an alternate 2 completion, cement in the production pipe from below any usable water to surface within 120 days of spud date.

State Corporation Commission of Kansas
 Conservation Division
 200 Colorado Derby Building
 Wichita, Kansas 67202